

MISSISSIPPI DEPARTMENT OF NATURAL RESOURCES

Bureau of Land and Water Resources

Southport Mall

P.O. Box 10631

Jackson, Mississippi 39209

WATER WELL DRILLERS LOG

Shuffler
Q
2000

Aug 26 1981 date well completed *Larry's well & pump* firm name *Shuffler* county well located

LANDOWNER:	description of formations encountered	from	to
<i>Ronnie Baird</i>	<i>clay</i>	<i>0</i>	<i>25</i>
<i>Shiveness no.</i> (mailing address)	<i>fine sand</i>	<i>25</i>	<i>40</i>
WELL LOCATION: sec. <i>27 19</i> N R. <i>4</i> E <i>2</i> miles N of <i>Franklin</i> (distance) (direction) (nearest town)	<i>med sand</i>	<i>40</i>	<i>60</i>
WELL PURPOSE: (home, irrigation, municipal, industrial)	<i>course sand & gravel</i>	<i>60</i>	<i>130</i>
WELL COMPLETION DATA:	<i>clay</i>	<i>130</i>	<i>200</i>
(1) diameter (inches) <i>4" x 2"</i>	<i>sand & clay streaks</i>	<i>200</i>	<i>500</i>
(2) total depth (feet)	<i>clay</i>	<i>500</i>	<i>750</i>
(3) static water level (feet) <i>20</i> below above top of ground.	<i>med sand</i>	<i>750</i>	<i>800</i>
(4) casing <i>plastic</i> <i>1770</i> (material) (depth)			
(size) if telescope see back.			
(5) screen <i>30</i> <i>770</i> (length) (depth to top)			
<i>2"</i> <i>plastic</i> (size) (material)			
(6) pump <i>1</i> <i>20</i> (HP) (yield gpm)			
<i>Electric</i> (type power)			
(7) electric log _____ (yes or no)			
_____ (organization running log)			
(8) how well bottom plugged _____			
DRILLERS REMARKS:			


DEPT. OF NATURAL RESOURCES
 BUREAU OF LAND & WATER RESOURCES

JAN 27 1982

RECEIVED

If well telescopes please sketch and show depths.

GROUND LEVEL

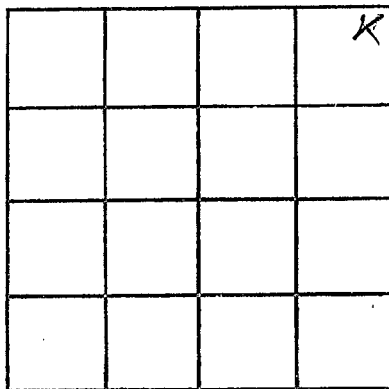

SECTION 27

Please indicate well location X.

ADDITIONAL INFORMATION

If more than one screen, show locations of each on sketch.