

SUNFLOWER
R 10
8-28-74

MISSISSIPPI
 BOARD OF WATER COMMISSIONERS **CODED**
 416 North State Street
 Jackson, Mississippi 39201

WATER WELL DRILLERS LOG

8/28/74 19 74 DUANE GAS CO. OF GREENWOOD Sunflower
 date well completed firm name county well located

LANDOWNER:	description of formations encountered	from	to
<u>R. Dinwiddie</u>			
<u>MOON HEAD</u> (mailing address)	<u>Clay</u>	<u>0</u>	<u>22</u>
	<u>Sand</u>	<u>22</u>	<u>90</u>
	<u>SAND + GRAVEL</u>	<u>90</u>	<u>120</u>
	<u>SAND</u>	<u>120</u>	<u>149</u>
	<u>Sand + SHALE</u>	<u>149</u>	<u>226</u>
	<u>SAND</u>	<u>226</u>	<u>255</u>
	<u>SAND + SHALE</u>	<u>255</u>	<u>270</u>
	<u>Sand</u>	<u>270</u>	<u>326</u>
	<u>SHALE</u>	<u>326</u>	<u>456</u>
	<u>SAND + SHALE</u>	<u>456</u>	<u>519</u>
	<u>SAND</u>	<u>519</u>	<u>542</u>
	<u>SHALE</u>	<u>542</u>	<u>565</u>

WELL LOCATION:
 sec. 1 T. 18 N. R. 3 E. W. 2
1 miles E of MOONHEAD
 (distance) (direction) (nearest town)

WELL PURPOSE: Home
 (home, irrigation, municipal, industrial)

- WELL COMPLETION DATA:
- (1) diameter (inches) 4 1/2
 - (2) total depth (feet) 543
 - (3) static water level (feet) 15 below top of ground
 - (4) casing Steel (material), 523 (depth)
4 1/2" (size) if telescope see back.
 - (5) screen 20" (length), 523 (depth to top)
2" (size), Stainless (material)
 - (6) pump 3/4 (HP), 20 (yield gpm)
Elec. (type power)
 - (7) electric log
 (organization running log)
 - (8) how well bottom plugged LEAD PIG

DISCOVERED
RECEIVED
 SEP 9 1974

DRILLERS REMARKS:


If well telescopes please sketch and show depths.

GROUND LEVEL

105' - 4" CASING →

418' - 2" CASING

20' - 2" SCREEN →

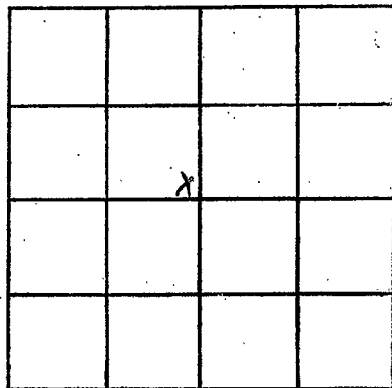

SECTION 1

Please indicate well location X.

ADDITIONAL INFORMATION

If more than one screen, show locations of each on sketch.