

SUNF.

MISSISSIPPI BOARD OF WATER COMMISSIONERS

~~R-24~~
1-31-61

R11

WATER WELL DRILLERS LOG

CODED

R11

Sunflower

Date: JAN. 31, 1961, Drillers: DELTA DRILLING Co. County: EFFLORE

(Name)

(1) Owner of Land: R. NATHAN SHEFFIELD
(Name)

Description & Color of Materials Sand, Clay, Red Clay, Shell, etc.	Thick-ness Feet	Depth Feet
---	-----------------	------------

GUMBO 18 18

SAND 68 86

GRAVEL 50 136

GUMBO 30 166

BROWN SAND 144 310

GUMBO 28 338

SAND 93 431

GUMBO 203 634

SAND 105 739

GUMBO 8" ROCK AT 945' 227 966

GREEN SAND w/9" ROCK 40 1006

SHALE 20 1026

GREEN SAND w/5+6" ROCKS 85 1111

SHALE 18 1129

SAND w/4" ROCK AT 1175' 106 1235

SHALE 22 1257

SAND w/9" ROCK AT 1295' 60 1317

SHALE 142 1459

WHITE SAND 82 1541

MOORHEAD, MISSISSIPPI
(Address) 20

(2) Location: 1/4, 1/4, Sec. 8 T18R3

 miles of
(distance) (direction) (Nearest Town)

(3) Topography: (Hilly) (Flat) (Level)

(4) Purpose of Well: DOMESTIC
(Domestic Irrigation
Municipal, Industrial, Other)

Information upon completion of well:

(1) Diameter 3 inches.

(2) Total Depth 1541 feet.

(3) Water Level WELL FLOWS feet below top of ground.

(4) Cased to 1541, Size 3" - 945' -
2" - 585' -
19' LAP OF 2" IN 3" PIPE

(5) Screen: Size 2", Length 30'


(6) Were any formations sealed against pollution?

 yes, no.

If YES depth of formation

Why

Drillers Remarks:

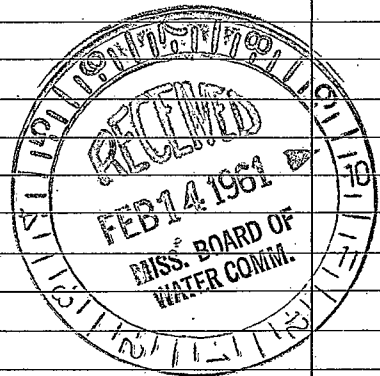

(Use Back Side)

Well No.

