

SUNF. MISSISSIPPI BOARD OF WATER COMMISSIONERS

OR 26
5-4-63

WATER WELL DRILLERS LOG

CODED

Date: 5/4, 1963, Driller: Bailey Drilling Co (Name) Washington County

(1) Owner of Land: Mrs. Merle Anderson
(Name)
Inverness, Miss.
(Address)

(2) Location: 1/4, 1/4, Sec. 32 T18R3,
3 miles east of Inverness
(distance) (direction) (Nearest Town)

(3) Topography: Flat
(Hilly) (Flat) (Level)

(4) Purpose of Well: domestic
(Domestic Irrigation
Municipal, Industrial, Other)

Description & Color of Materials Sand, Clay, Red Clay, Shell, etc.	Thick- ness Feet	Depth Feet
Clay		20
Sand		50
Gravel		70
Mud		835
Sand		860

Information upon completion of well:

(1) Diameter: 3x2 inches.

(2) Total Depth: 860 feet.


(3) Water Level: 13 feet below top of ground.

(4) Cased to: all way, Size: 3x2

(5) Screen: Size: 2", Length: 20ft

(6) Were any formations sealed against pollution?
yes, no.

CODED

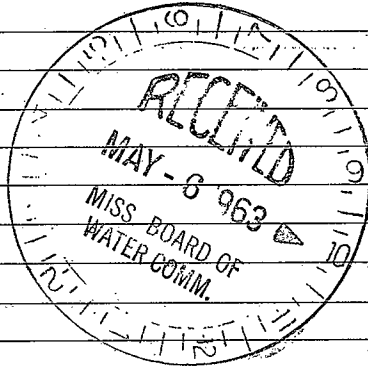

If YES depth of formation _____

Why _____

Drillers Remarks: _____

Well No.

(Use Back Side)

