

SUNF. MISSISSIPPI BOARD OF WATER COMMISSIONERS

R28
12-9-65

WATER WELL DRILLERS LOG

CODED

Date: DEC 9, 1965, Driller: DELTA DRILLING Co County: SUNFLOWER
(Name)

(1) Owner of Land: C. F. FITTS
(Name)
MOORHEAD, MISS.
(Address)

(2) Location: 1/4, 1/4, Sec 26 T18 R3,
_____ miles _____ of _____
(distance) (direction) (Nearest Town)

(3) Topography: _____
(Hilly) (Flat) (Level)

(4) Purpose of Well: DOMESTIC
(Domestic Irrigation
Municipal, Industrial, Other)

Description & Color of Materials Sand, Clay, Red Clay, Shell, etc.	Thick- ness Feet	Depth Feet
SAND	86	86
GRAVEL	33	119
GUMBO	21	140
SAND	161	311
SHALE	57	368
SAND	41	409
GUMBO	83	492
SAND	83	575
GUMBO	104	679
SHALE	23	702
GUMBO	166	868
GREEN SAND	192	1060
SHALE	120	1180
GUMBO	26	1206
SHALE w/ROCKS-	104	1310
GUMBO	34	1344
SAND	82	1426
SHALE	12	1418
SAND	27	1445
SHALE	20	1465
SAND	60	1525

Information upon completion of well:

(1) Diameter 3 inches.

(2) Total Depth 1525 feet.


(3) Water Level FLOWS feet below top of ground.

(4) Cased to 1500, Size 799 L 3" 735'-2"

(5) Screen: Size 2", Length 20'

(6) Were any formations sealed against pollution?
_____ yes, _____ no.

If YES depth of formation _____
Why _____
Drillers Remarks: 25' LAP OF 2" IN 3"
PIPE - 10' 2" TAIL PIPE ON
BOTTOM END OF WELL

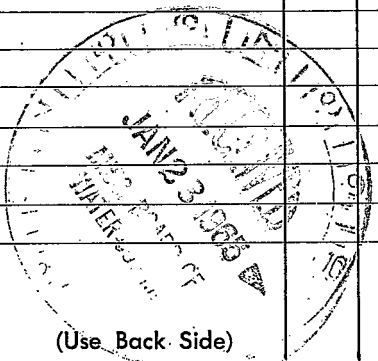

(Use Back Side)

Well No.

