

SUNFLOWER
R-29
9-13-71

MISSISSIPPI
 BOARD OF WATER COMMISSIONERS
 416 North State Street
 Jackson, Mississippi 39201

WATER WELL DRILLERS LOG

CODED

BULANE GAS CO. OF GREENWOOD

9-13-71
 date well completed

firm name


county well located

LANDOWNER:	description of formations encountered	from	to
Preston Hays	Clay	0	24
Itha Bena (mailing address)	Sand	24	95
	Sand + Gravel	95	130
WELL LOCATION:	Clay	130	163
sec. <u>1</u> T. <u>18</u> N. R. <u>3</u> E	Shale	163	200
S W	Sand + Shale	200	285
<u>3</u> miles <u>E</u> of <u>Moorhead</u>	Gummy Shale	285	378
(distance) (direction) (nearest town)	Sand	378	383
WELL PURPOSE: <u>Home</u>	Gummy Shale	383	426
(home, irrigation, municipal, industrial)	Sandy Shale	426	570
WELL COMPLETION DATA:	Sand	570	530
(1) diameter (inches) <u>2</u> "	Gummy Shale	530	627
(2) total depth (feet) <u>1279</u>	Sand	627	652
(3) static water level (feet) <u>25</u> below top of ground.	Gummy Shale	652	713
(4) casing <u>Steel</u> (material) <u>1239</u> (depth)	Hard Shale	713	745
<u>2</u> " (size) if telescope see back.	Rock	745	747
(5) screen <u>40'</u> (length) <u>1239</u> (depth to top)	Shale	747	757
<u>2</u> " (size) <u>Stainless Steel</u> (material)	Rock	757	758
(6) pump <u>0</u> (HP) <u>20</u> (yield gpm)	Sand-Shale-Rock	758	775
<u>None</u> (type power)	Rock	775	776
(7) electric log <u>No</u> (yes or no)	Shale + Sand	776	863
(organization running log)	Rock	863	865
(8) how well bottom plugged <u>Lead Plug</u>	Shale	865	877
	Rock	877	878
	Shale	878	926
	Rock	926	927
	Shale	927	930
	Rock	930	931
	Shale	931	943
	Rock	943	944
	Shale	944	947
	Rock	947	948
	Shale	948	1021
	Rock	1021	1022
	Shale	1022	1023
	Rock	1023	1024
DRILLERS REMARKS:	Shale	1024	1052
	Brown Sand	1052	1075
	Sandy Shale	1075	1213
	Sand Weh	1213	1357
	Gummy Shale	1357	1367
	Sand	1367	1409
	Rock + Shale		1409-1507

CODED

If well telescopes please sketch and show depths.

GROUND LEVEL

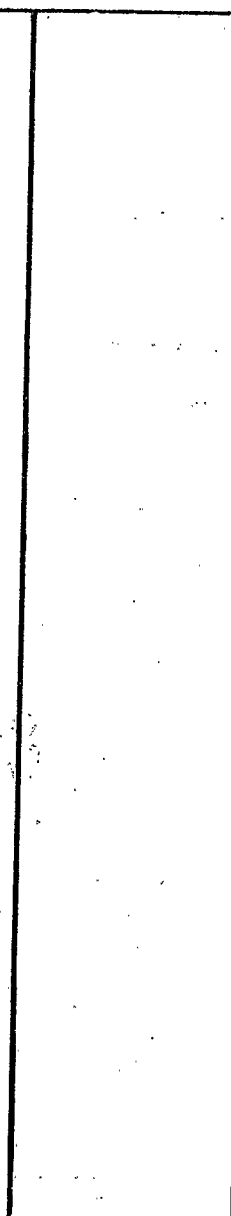


			X

SECTION 1

Please indicate well location X.

ADDITIONAL INFORMATION

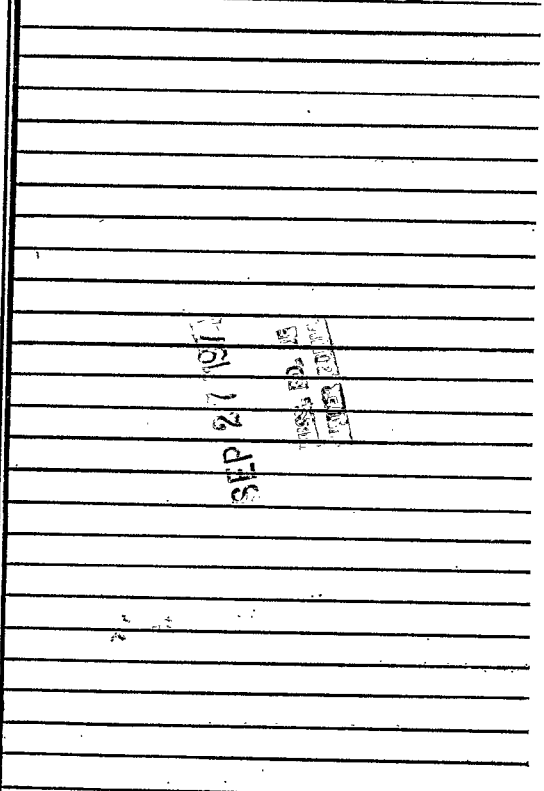

SEP 27 1971
RECEIVED
WATER DIVISION

If more than one screen, show locations of each on sketch.