

CODED

MISSISSIPPI  
BOARD OF WATER COMMISSIONERS  
416 North State Street  
Jackson, Mississippi 39201

WATER WELL DRILLERS LOG

SUNFLOWER  
R 35  
2-28-74

2-28 1974 Hester Drilling Co Sunflower  
date well completed firm name county well located

LANDOWNER: Anderson, fish  
Monarch  
(mailing address)

Description of formations encountered	from	to
<u>clay</u>	<u>0</u>	<u>40</u>
<u>fine sand</u>	<u>40</u>	<u>53</u>
<u>coarse sand</u>	<u>53</u>	<u>100</u>
<u>gravel</u>		


WELL LOCATION:  
sec. 11 T. 18 S. R. 3 E.  
1 miles N.E. of Monarch  
(distance) (direction) (nearest town)

WELL PURPOSE: fish  
(home, irrigation, municipal, industrial)

WELL COMPLETION DATA:

- (1) diameter (inches) 16
- (2) total depth (feet) 100
- (3) static water level (feet) 18 below above top of ground.
- (4) casing steel, 60 (material) (depth)  
16 (size) if telescope see back.
- (5) screen 40, 60 (length) (depth to top)  
16, steel (size) (material)
- (6) pump 50, 2000 (HP) (yield gpm)  
Electric (type power)
- (7) electric log no (yes or no)
- (8) how well bottom plugged \_\_\_\_\_  
(organization running log)

CODED

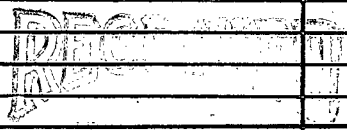


MAR 20 1974

DRILLERS REMARKS:

If well telescopes please sketch and show depths.

GROUND LEVEL

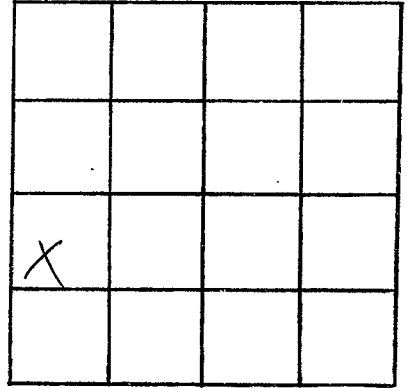

SECTION 11

Please indicate well location X.

ADDITIONAL INFORMATION

If more than one screen, show locations of each on sketch.