

SUNFLOWER
R. 36
5-6-74

MISSISSIPPI
 BOARD OF WATER COMMISSIONERS **CODED**
 416 North State Street
 Jackson, Mississippi 39201

WATER WELL DRILLERS LOG

May 6, 1974 BRUCE BERRYMAN Sunflower
 date well completed Greenwood county well located

LANDOWNER:	Harris Russell	description of formations encountered	from	to
Box 297, Moorhead,		Clay	0	17
Mississippi. 38761		Sand	17	63
(mailing address)		Sand & gravel	63	129
		Clay	129	133
WELL LOCATION:		Clay & sand	133	323
sec. <u>22</u> T. <u>18</u> N. R. <u>3</u> W.		Sand & shale	323	355
$\frac{1}{2}$ miles South Moorhead		Sand	355	470
(distance) (direction) (nearest town)		Gummy shale	470	525
WELL PURPOSE: Home		Sand & shale	525	665
(home, irrigation, municipal, industrial)		Shale & sand str.	665	722
WELL COMPLETION DATA:		Shale	722	820
(1) diameter (inches) <u>4" x 2"</u>		Shale & dirty sand	820	1020
(2) total depth (feet) <u>1040'</u>		Sand	1020	1040
(3) static water level (feet) <u>Flow</u> below top of ground.				
(4) casing <u>3" blk. pipe</u> = 126'				
<u>3" galv. pipe</u> = 894'				
(material) (depth)				
<u>4"</u> If telescope see back.				
(size)				
(5) screen <u>20'</u> .010 <u>1020'</u>				
(length) (depth to top)				
<u>2"</u> stainless steel				
(size) (material)				
(6) pump <u>3/4</u> <u>19</u>				
(HP) (yield gpm)				
<u>Electric</u>				
(type power)				
(7) electric log <u>No</u>				
(yes or no)				
<u>(organization running log)</u>				
(8) how well bottom plugged <u>B.P.V.</u>				
DRILLERS REMARKS:				


CODED

RECORDED
 MAY 29 1974

MISS. DEPT. OF AGRICULTURE

If well telescopes please sketch and show depths.

GROUND LEVEL

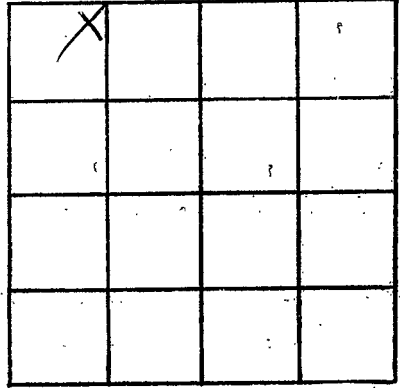

SECTION 22

Please indicate well location X.

ADDITIONAL INFORMATION

If more than one screen, show locations of each on sketch.