

**SUNFLOWER**  
**R 37**  
**9-23-74**

MISSISSIPPI  
 BOARD OF WATER COMMISSIONERS  
 416 North State Street  
 Jackson, Mississippi 39201

**WATER WELL DRILLERS LOG**

9-23 19 74 Hester Drilling Sunflower  
 date well completed firm name county well located

LANDOWNER:	description of formations encountered	from	to
		<u>Federal Court</u>	<u>0</u>
(mailing address)	<u>CLAY</u>	<u>45</u>	<u>55</u>
	<u>FINE SAND</u>	<u>55</u>	<u>115</u>
	<u>COARSE SAND</u>		

WELL LOCATION:  
 sec. 12 T. 18 N. R. 3 E  
3 miles NE of Moore Head, Miss  
 (distance) (direction) (nearest town)

WELL PURPOSE: CAT FISH  
 (home, irrigation, municipal, industrial)

- WELL COMPLETION DATA:
- (1) diameter (inches) 16"
  - (2) total depth (feet) 115
  - (3) static water level (feet) 25 below/above top of ground
  - (4) casing steel, 75' (material) (depth)  
16" if telescope see back. (size)
  - (5) screen 40', 75' (length) (depth to top)  
16", steel (size) (material)
  - (6) pump 50 2000 (HP) (yield gpm)  
Electric (type power)
  - (7) electric log no (yes or no)
  - (organization running log)
  - (8) how well bottom plugged Plastic


DRILLERS REMARKS:  
As per [unclear]

RECEIVED  
 OCT 29 1974

MISS. BD. OF WATER COMMISSIONERS

If well telescopes please sketch and show depths.

GROUND LEVEL

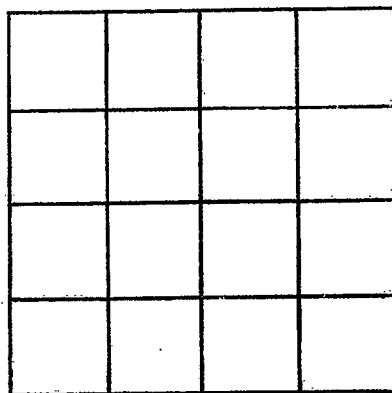

SECTION \_\_\_\_\_

Please indicate well location X.

ADDITIONAL INFORMATION

If more than one screen, show locations of each on sketch.