

MISSISSIPPI BOARD OF WATER COMMISSIONERS

Sunflower

R 39
7-66

WATER WELL DRILLERS LOG

Sunflower

Date: 7-8, 1966, Driller: Burtone Gas Co. County: Leflore
(Name)

(1) Owner of Land: A. K. Maxwell
(Name)
Moorehead, Miss.
(Address)

(2) Location: SW 1/4, SW 1/4, Sec 21 T18 R74
3 miles S, of Moorehead
(distance) (direction) (Nearest Town)

(3) Topography: Flat
(Hilly) (Flat) (Level)

(4) Purpose of Well: Irrigation
(Domestic Irrigation
Municipal, Industrial, Other)

| Description & Color of Materials Sand, Clay, Red Clay, Shell, etc. | Thick- ness Feet | Depth Feet |
|---|------------------------|---------------|
| Clay | 13 | 13 |
| Clay | 10 | 23 |
| Blue Clay | 10 | 33 |
| Med. Sand | 10 | 43 |
| Med. Sand | 10 | 53 |
| Coarse Sand | 10 | 63 |
| Coarse Sand - Gravel | 10 | 73 |
| " " " | 10 | 83 |
| " " " | 10 | 93 |
| " " " | 10 | 103 |

Information upon completion of well:

(1) Diameter 12 inches.

(2) Total Depth 103 feet.

(3) Water Level 20 feet below top of ground.

(4) Cased to 63, Size 12.


(5) Screen: Size 12, Length 40.

(6) Were any formations sealed against pollution?
_____ yes, X no.

If YES depth of formation _____

Why _____

Drillers Remarks: _____

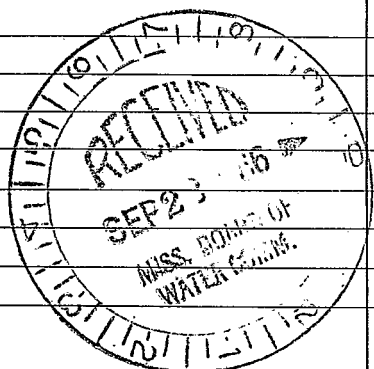

(Use Back Side)

Well No.

Retain this copy for your office files.

