

CODED

MISSISSIPPI
BOARD OF WATER COMMISSIONERS
416 North State Street
Jackson, Mississippi 39201

WATER WELL DRILLERS LOG

SUNFLOWER
R 42
2-22-75

February 22, 1975 Dyer-Sullivan Sunflower
date well completed firm name county well located

LANDOWNER: Fitts Bros.

description of formations encountered

from to

R.R. 1 Box 175
Moorhead, Miss. 38761
(mailing address)

Clay 0 29
FINE SAND 29 73
SAND + GRAVEL 73 103


WELL LOCATION:

sec. 34 T. 18 N R. 3 E 15 J
4 miles S of Moorhead
(distance) (direction) (nearest town)

WELL PURPOSE: Irrigation
(home, irrigation, municipal, industrial)

WELL COMPLETION DATA:

- (1) diameter (inches) 16"
- (2) total depth (feet) 103'
- (3) static water level (feet) 11 below above top of ground.
- (4) casing BIK Iron, 73', (material) (depth)
16" (size) if telescope see back.
- (5) screen 40', 73' (length) (depth to top)
16", BIK Ingot (size) (material)
- (6) pump 60 (HP) 3000 (yield gpm)
Diesel (type power)
- (7) electric log No (yes or no)
(organization running log)
- (8) how well bottom plugged Plate

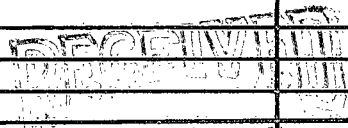


OCT 18 1975

DRILLERS REMARKS:

If well telescopes please sketch and show depths.

GROUND LEVEL

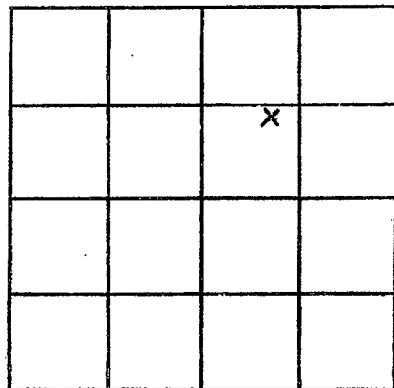

SECTION 34

Please indicate well location X.

ADDITIONAL INFORMATION

If more than one screen,
show locations of each on sketch.