

SUNFLOWER
R 43
3/7/78

MISSISSIPPI
BOARD OF WATER COMMISSIONERS
416 North State Street
Jackson, Mississippi 39201

CODED

WATER WELL DRILLERS LOG

March 7 1978 Bruce Berryman - Sunflower
date well completed firm name county well located

LANDOWNER: Mr. Ciro Noble
Rt. 1. Box 125

Moorhead, MS 38761

(mailing address)

WELL LOCATION:

sec. 5 T. 18 N R. 3 W
3 miles W of MOORHEAD
(distance) (direction) (nearest town)

WELL PURPOSE: Home
(home, irrigation, municipal, industrial)

WELL COMPLETION DATA:

- (1) diameter (inches) 4" x 2"
(2) total depth (feet) 1054 ft.
(3) static water level (feet) flow above top of ground. blk. = 126'
(4) casing 2" galv. = 908'
(material) (depth)
If telescope see back.
(size)
(5) screen 20' 1034'
(length) (depth to top)
.010 stainless steel
(size) (material)
(6) pump 1 35
(HP) (yield gpm)
Electric
(type power)
(7) electric log No
(yes or no)
(organization running log)
(8) how well bottom plugged B.P.V.

description of formations encountered	from	to
Clay	0	20
Sand	20	80
Sand & Gravel	80	120
Clay	120	140
Sand	140	200
Clay	200	240
Sandy Clay	240	340
Sand	340	360
Sandy shale	360	500
Sand	500	520
Shale CODED	520	540
Hard Shale	540	580
Shale	580	760
Brown sand	760	770
Clay	770	780
Shale	780	940
Rock & Shale	940	1000
Shale	1000	1030
Sand	1030	1050
Shale	1050	1070


DRILLERS REMARKS:

RECEIVED
NOV - 7 1978

MISS. BD. OF WATER COMMISSIONERS

If well telescopes please sketch and show depths.

GROUND LEVEL

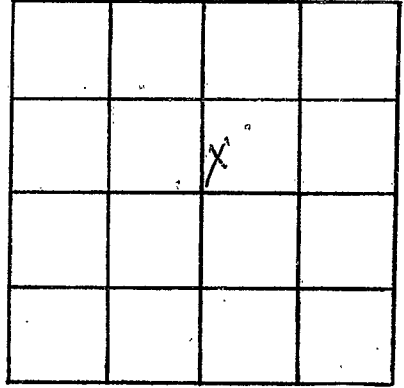

SECTION 5

Please indicate well location X.

ADDITIONAL INFORMATION

If more than one screen, show locations of each on sketch.