

SUNFLOWER
R 44
2/7/78

MISSISSIPPI
BOARD OF WATER COMMISSIONERS
416 North State Street
Jackson, Mississippi 39201

CODED

WATER WELL DRILLERS LOG

February 7, 1978 Dyer Well + Irrigation Sunflower
date well completed firm name county well located

LANDOWNER: HARRIS RUSSELL

Marzhead, Miss.
(mailing address)

WELL LOCATION:
sec. 11 T. 18 N R. 3 E
3 miles East of Marzhead
(distance) (direction) (nearest town)

WELL PURPOSE: Irrigation
(home, irrigation, municipal, industrial)

WELL COMPLETION DATA:

- (1) diameter (inches) 12"
- (2) total depth (feet) 113'
- (3) static water level (feet) 17' below top of ground.
- (4) casing Steel, 73' (material) (depth)
12" (size) If telescope see back.
- (5) screen 40', 73' (length) (depth to top)
12" (size) Steel (material)
- (6) pump 40 (HP) 2,000 (yield gpm)
Diesel (type power)
- (7) electric log NO (yes or no)
(organization running log)
- (8) how well bottom plugged Plate

description of formations encountered	from	to
Clay	0	13
Clay	13	23
Clay	23	33
Fine Sand CODED	33	43
Fine Sand	43	53
Fine Sand	53	63
SAND + GRAVEL	63	73
SAND + GRAVEL	73	83
SAND + GRAVEL	83	93
SAND + GRAVEL	93	103
SAND + GRAVEL	103	113

Miss. Board of Water Comm.


FEB 8 1978

RECEIVED

DRILLERS REMARKS:

If well telescopes please sketch and show depths.

GROUND LEVEL

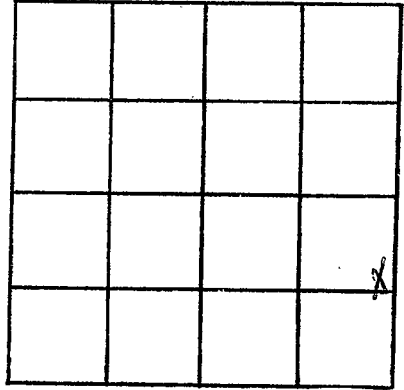

SECTION 11

Please indicate well location X.

ADDITIONAL INFORMATION

A series of 20 horizontal lines for recording additional information.

If more than one screen, show locations of each on sketch.