

SUNFLOWER

R 45

2/8/78

MISSISSIPPI BOARD OF WATER COMMISSIONERS CODED  
 416 North State Street  
 Jackson, Mississippi 39201

WATER WELL DRILLERS LOG

February 8, 1978 Dyer Well Irrigation Sunflower  
 date well completed firm name county well located


LANDOWNER: <u>HARRIS RUSSELL</u>	description of formations encountered	from	to
<u>Moorehead, Miss.</u> (mailing address)	Clay	0	13
	Clay	13	23
	Clay	23	33
WELL LOCATION: sec. <u>11</u> T. <u>18</u> N. R. <u>3</u> E <u>2</u> miles <u>EAST</u> of <u>Moorehead</u> (distance) (direction) (nearest town)	FINE SAND	33	43
	FINE SAND <b>CODED</b>	43	53
	FINE SAND	53	63
	SAND + GRAVEL	63	73
	SAND + GRAVEL	73	83
WELL PURPOSE: <u>irrigation</u> (home, irrigation, municipal, industrial)	SAND + GRAVEL	83	93
	SAND + GRAVEL	93	103
WELL COMPLETION DATA:	SAND + GRAVEL	103	113
(1) diameter (inches) <u>12"</u>			
(2) total depth (feet) <u>113'</u>			
(3) static water level (feet) <u>17'</u> below above top of ground.			
(4) casing <u>STEEL</u> , <u>73'</u> 12 (material) (depth) <u>4 1/2"</u> If telescope see back. (size)			
(5) screen <u>40'</u> , <u>73'</u> 12" (length) (depth to top) <u>1/2"</u> , <u>STEEL</u> (size) (material)			
(6) pump <u>40</u> <u>2,000</u> (HP) (yield gpm) <u>DIESEL</u> (type power)			
(7) electric log <u>No</u> (yes or no) <u>Miss. Board of Water Comm.</u> (organization running log)			
(8) how well bottom plugged <u>Plate</u>			
DRILLERS REMARKS:			

FEB 8 1978

RECEIVED

If well telescopes please sketch and show depths.

GROUND LEVEL

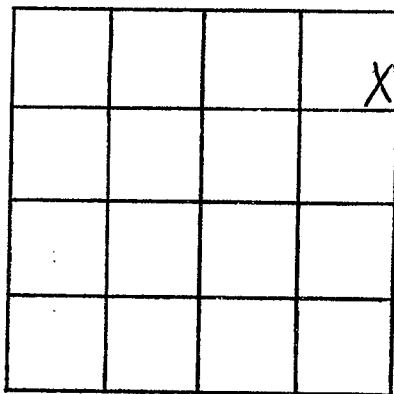

SECTION 11

Please indicate well location X.

ADDITIONAL INFORMATION

If more than one screen,  
show locations of each on sketch.