

SUNFLOWER
R47
4/3/78

MISSISSIPPI
BOARD OF WATER COMMISSIONERS
416 North State Street
Jackson, Mississippi 39201

CODED

WATER WELL DRILLERS LOG

April 3, 1978 date well completed
Roberson's Water Wells firm name
Lumb County county well located

LANDOWNER:	description of formations encountered	from	to
Don Russell B-297 MOOREHEAD, Mississippi (mailing address)			
WELL LOCATION: sec. 1 T. 18 N. R. 3 E. 1 1/2 miles EAST of MOOREHEAD (distance) (direction) (nearest town)			
WELL PURPOSE: (home, irrigation, municipal, industrial)			
WELL COMPLETION DATA:			
(1) diameter (inches) 8"			
(2) total depth (feet) 100'			
(3) static water level (feet) 16' below top of ground.			
(4) casing PUC 160 PSI (material) (depth)			
(size) if telescope see back.			
(5) screen 30' 70' (length) (depth to top)			
8" P.O.C. (size) (material)			
(6) pump 1 1/2 500 (HP) (yield gpm)			
Electric (type power)			
(7) electric log (yes or no)			
(organization running log)			
(8) how well bottom plugged capped			
DRILLERS REMARKS:			

CODED


Miss. Board of Water Comm.

APR 16 1978

RECEIVED

If well telescopes please sketch and show depths.

GROUND LEVEL

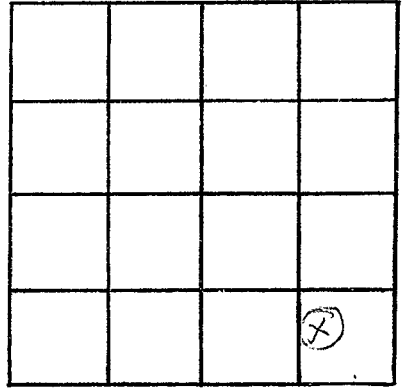

SECTION _____

Please indicate well location X.

ADDITIONAL INFORMATION

If more than one screen,
show locations of each on sketch.