

SUNFLOWER
R 48
3/28/78

MISSISSIPPI
BOARD OF WATER COMMISSIONERS
416 North State Street
Jackson, Mississippi 39201

WATER WELL DRILLERS LOG CODED

March 28 1978 Reheiss's Well Drilling Sunflower
date well completed firm name county well located

LANDOWNER:

Ben Cartwright

Morehead, Mississippi
(mailing address)

description of formations encountered

from to

Top soil	0	5
Clay	5	30'
White coarse sand	30'	100'

WELL LOCATION:

sec. 13 T 18 N R 30 E
S W
2 miles east of Morehead
(distance) (direction) (nearest town)

CODED

WELL PURPOSE:

(home, irrigation, municipal, industrial)

WELL COMPLETION DATA:

- diameter (inches) 8"
- total depth (feet) 100'
- static water level (feet) 18 below top of ground.
- casing P.O.C. 160 PSI
(material) (depth)
(size) if telescope see back.
- screen 30' 70'
(length) (depth to top)
8" P.O.C.
(size) (material)
- pump 7 1/2 500 gpm.
(HP) (yield gpm)
electric
(type power)
- electric log (yes or no)
(organization running log)
- how well bottom plugged capped

DRILLERS REMARKS:


Miss. Board of Water Comm.

APR 16 1979

RECEIVED

If well telescopes please sketch and show depths.

GROUND LEVEL

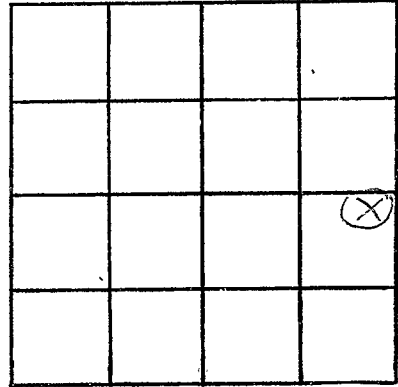

SECTION 13

Please indicate well location X.

ADDITIONAL INFORMATION

If more than one screen,
show locations of each on sketch.