

SUNFLOWER  
R49  
3/27/78

MISSISSIPPI  
BOARD OF WATER COMMISSIONERS  
416 North State Street  
Jackson, Mississippi 39201

CODED

WATER WELL DRILLERS LOG

March 27, 1978 <sup>19</sup> Roberson's Water Wells Sunflower  
date well completed firm name county well located

LANDOWNER:	description of formations encountered	from	to
<u>Ben Casturight</u>			
<u>Moorehead, Mississippi</u> (mailing address)	<u>Clay</u>	<u>5</u>	<u>30'</u>
	<u>White, coarse sand</u>	<u>30</u>	<u>100'</u>
<b>WELL LOCATION:</b>			
sec. <u>12</u> T. <u>18</u> (N) S. R. <u>3</u> (E) W.			
<u>2</u> miles <u>EAST</u> of <u>MOOREHEAD</u> (distance) (direction) (nearest town)			
<b>WELL PURPOSE:</b> (home, irrigation, municipal, industrial)			
<b>WELL COMPLETION DATA:</b>			
(1) diameter (inches) <u>8"</u>			
(2) total depth (feet) <u>100'</u>			
(3) static water level (feet) <u>18</u> <sup>below</sup> <sub>above</sub> top of ground.			
(4) casing <u>P.O.C.</u> <u>160 PSI</u> (material) (depth)			
<u>      </u> (size) If telescope see back.			
(5) screen <u>30'</u> <u>70'</u> (length) (depth to top)			
<u>8"</u> <u>P.O.C.</u> (size) (material)			
(6) pump <u>7 1/2</u> <u>500</u> (HP) (yield gpm)			
<u>Electric</u> (type power)			
(7) electric log <u>      </u> (yes or no)			
<u>      </u> (organization running log)			
(8) how well bottom plugged <u>CAPPED</u>			

CODED

Miss. Board of Water Comm.


APR 16 1978

RECEIVED

DRILLERS REMARKS:

If well telescopes please sketch and show depths.

GROUND LEVEL

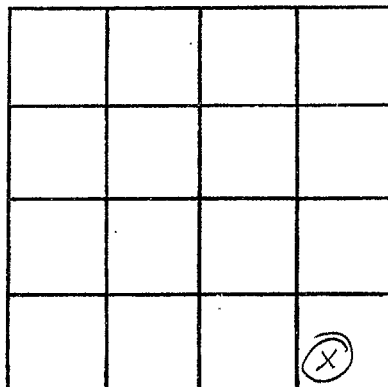

SECTION \_\_\_\_\_

Please indicate well location X.

ADDITIONAL INFORMATION

If more than one screen, show locations of each on sketch.