

SUNFLOWER
R 51
3/28/78

MISSISSIPPI
BOARD OF WATER COMMISSIONERS
416 North State Street
Jackson, Mississippi 39201

CODED

WATER WELL DRILLERS LOG

March 28, 1978 date well completed
Raherson's Waterwells firm name
Sunflower county well located

LANDOWNER:	description of formations encountered	from	to
Ben Cartwright			
Morehead, Mississippi (mailing address)	Top soil	0	5
	Clay	5	30
	Coarse White sand	30	100'
WELL LOCATION:			
sec. 13 T 18 N R 30 W			
2 miles EAST of MOREHEAD (distance) (direction) (nearest town)			
WELL PURPOSE:			
(home, irrigation, municipal, industrial)			
WELL COMPLETION DATA:			
(1) diameter (inches) 8"			
(2) total depth (feet) 100'			
(3) static water level (feet) 18' below top of ground.			
(4) casing PVC 160 PSI (material) (depth)			
(size) If telescope see back.			
(5) screen 30' 70' (length) (depth to top)			
8" PVC (size) (material)			
(6) pump 7 1/2 500 (HP) (yield gpm)			
Electric (type power)			
(7) electric log (yes or no)			
(organization running log)			
(8) how well bottom plugged CAPPED			
DRILLERS REMARKS:			

CODED


Miss. Board of Water Comm.

APR 16 1979

RECEIVED

If well telescopes please sketch and show depths.

GROUND LEVEL

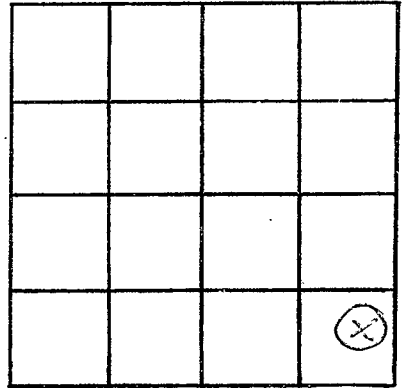

SECTION _____

Please indicate well location X.

ADDITIONAL INFORMATION

If more than one screen,
show locations of each on sketch.