

SUNFLOWER
R52
4/3/78

MISSISSIPPI
BOARD OF WATER COMMISSIONERS
416 North State Street
Jackson, Mississippi 39201

CODED

WATER WELL DRILLERS LOG

April 3 1978 19 Reliance's Water Wells Sunflower
date well completed firm name county well located

LANDOWNER:	description of formations encountered	from	to
<u>Charlie Roberts</u>			
<u>Monroeville, Mississippi</u> (mailing address)	<u>Top Soil</u>	<u>0</u>	<u>5</u>
WELL LOCATION: sec. <u>2</u> T <u>18</u> (N) S R <u>3</u> E (W)	<u>CLAY</u>	<u>5</u>	<u>30</u>
<u>1 1/2</u> miles <u>EAST</u> of <u>Monroeville</u> (distance) (direction) (nearest town)	<u>White coarse sand</u>	<u>100</u>	
WELL PURPOSE: (home, irrigation, municipal, industrial)			
WELL COMPLETION DATA:			
(1) diameter (inches) <u>8"</u>			
(2) total depth (feet) <u>100'</u>			
(3) static water level (feet) <u>18</u> ^{below} _{above} top of ground.			
(4) casing <u>PVC</u> , <u>160 PSI</u> (material) (depth) <u> </u> if telescope see back. (size)			
(5) screen <u>40'</u> , <u>60'</u> (length) (depth to top)			
<u>8"</u> , <u>PVC</u> (size) (material)			
(6) pump <u>25</u> , <u>1000</u> (HP) (yield gpm)			
<u>Electric</u> (type power)			
(7) electric log <u> </u> (yes or no)			
<u> </u> (organization running log)			
(8) how well bottom plugged <u>CAPPED</u>			
DRILLERS REMARKS:			

CODED


Miss. Board of Water Comm.

APR 16 1978

RECEIVED

If well telescopes please sketch and show depths.

GROUND LEVEL

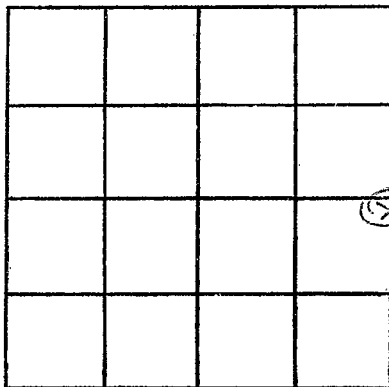

SECTION _____

Please indicate well location X.

ADDITIONAL INFORMATION

If more than one screen, show locations of each on sketch.