

SUNFLOWER
R 53
4/4/78

MISSISSIPPI
BOARD OF WATER COMMISSIONERS
416 North State Street
Jackson, Mississippi 39201

CODED

WATER WELL DRILLERS LOG

April 4, 1978 19 Roberson's Water Wells Sunflower
date well completed firm name county/well located

LANDOWNER:	description of formations encountered	from	to
<u>Everett Williamson</u>	<u>top soil</u>	<u>0</u>	<u>5</u>
<u>R-1 B-16</u>	<u>Clay</u>	<u>5</u>	<u>30'</u>
<u>Moorehead, Mississippi</u> (mailing address)	<u>white coarse sand</u>	<u>30'</u>	<u>100'</u>

WELL LOCATION:
sec. 12 T 18 (N) R. 3 (E) (W)
2 miles EAST of Moorehead
(distance) (direction) (nearest town)

CODED

WELL PURPOSE:
(home, irrigation, municipal, industrial)

- WELL COMPLETION DATA:
- (1) diameter (inches) 8"
 - (2) total depth (feet) 100'
 - (3) static water level (feet) 18 below above
top of ground.
 - (4) casing PVC 160 PSI
(material) (depth)
 if telescope see back.
(size)
 - (5) screen 30' 70'
(length) (depth to top)
8" PVC
(size) (material)
 - (6) pump 7 1/2 500
(HP) (yield gpm)
Electric
(type power)
 - (7) electric log
(yes or no)

(organization running log)
 - (8) how well bottom plugged CAPPED

Miss. Board of Water Comm.


APR 16 1978

RECEIVED

DRILLERS REMARKS:

If well telescopes please sketch and show depths.

GROUND LEVEL

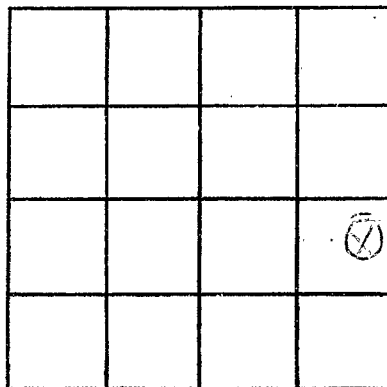

SECTION _____

Please indicate well location X.

ADDITIONAL INFORMATION

If more than one screen,
show locations of each on sketch.