

SUNFLOWER
R54
4/4/78

MISSISSIPPI
BOARD OF WATER COMMISSIONERS
416 North State Street
Jackson, Mississippi 39201

CODED

WATER WELL DRILLERS LOG

April 4, 1978 19 Reherson's Water Wells Sunflower
date well completed firm name county/well located

LANDOWNER:	description of formations encountered	from	to
<u>Everett Williamson</u>	<u>Top soil</u>	<u>0</u>	<u>5</u>
<u>R-1 B-16</u>	<u>Clay</u>	<u>5</u>	<u>30'</u>
<u>Moorestown, Mississippi</u> (mailing address)	<u>White coarse sand</u>	<u>30</u>	<u>100'</u>
WELL LOCATION: sec. <u>12</u> T. <u>18</u> N. R. <u>3</u> E S. W.			
<u>2</u> miles <u>EAST</u> of <u>Moorestown</u> (distance) (direction) (nearest town)			
WELL PURPOSE: (home, irrigation, municipal, industrial)			
WELL COMPLETION DATA:			
(1) diameter (inches) <u>8"</u>			
(2) total depth (feet) <u>100'</u>			
(3) static water level (feet) <u>18</u> <u>below</u> top of ground. above			
(4) casing <u>P.V.C.</u> <u>160</u> <u>PST</u> (material) (depth)			
<u> </u> if telescope see back. (size)			
(5) screen <u>30'</u> <u>70'</u> (length) (depth to top)			
<u>8"</u> <u>P.V.C.</u> (size) (material)			
(6) pump <u>7 1/2</u> <u>500</u> <u>gpm</u> (HP) (yield gpm)			
<u>Electric</u> (type power)			
(7) electric log <u> </u> (yes or no)			
<u> </u> (organization running log)			
(8) how well bottom plugged <u>CAPPED</u>			

CODED

Miss. Board of Water Comm.


APR 16 1978

RECEIVED

DRILLERS REMARKS:

If well telescopes please sketch and show depths.

GROUND LEVEL

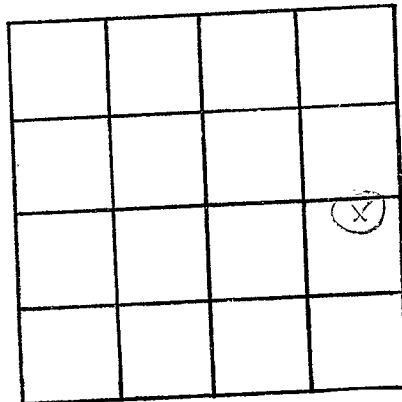

SECTION _____

Please indicate well location X.

ADDITIONAL INFORMATION

If more than one screen,
show locations of each on sketch.