

SUNFLOWER  
R55  
7-5-79

MISSISSIPPI  
BOARD OF WATER COMMISSIONERS  
416 North State Street  
Jackson, Mississippi 39201

CODED

WATER WELL DRILLERS LOG

7-5-79  
date well completed

1979 Larry Wells Pump  
firm name

Sunflower Co  
county, well located

LANDOWNER: Ben Heilbrecht

Leland Miss

(mailing address)

WELL LOCATION:

sec. 33 T 18 N S

R. E 3 W

4 E miles 1 N of Inverness  
(distance) (direction) (nearest town)

WELL PURPOSE:

(home, irrigation, municipal, industrial)

WELL COMPLETION DATA:

- (1) diameter (inches) 16"
- (2) total depth (feet) 124'
- (3) static water level (feet) 17' below top of ground.

(4) casing steel 74'  
(material) (depth)

(size) if telescope see back.

(5) screen 40 74'  
(length) (depth to top)

16" steel  
(size) (material)

(6) pump 60 3600  
(HP) (yield gpm)

gas  
(type power)

(7) electric log (yes or no)

(organization running log)

(8) how well bottom plugged steel plate

description of formations encountered

from to

clay	6	15
fine sand	15	25
med & coarse sand	25	35
coarse sand	35	69
coarse sand & clay	69	73
coarse sand & gravel	73	124

CODED

DRILLERS REMARKS:


Miss. Board of Water Comm.

AUG 21 1979

RECEIVED

If well telescopes please sketch and show depths.

GROUND LEVEL

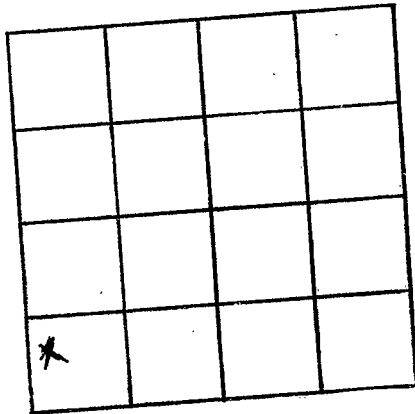

SECTION 33

Please indicate well location X.

ADDITIONAL INFORMATION

If more than one screen, show locations of each on sketch.