

Sunflower

MISSISSIPPI DEPARTMENT OF NATURAL RESOURCES

Bureau of Land and Water Resources

Southport Mall

P.O. Box 10631

Jackson, Mississippi 39209

CODED

WATER WELL DRILLERS LOG

R-59

#3

4-16-80

4-16-80

Larry's Well + Pump

Sunflower

date well completed

firm name

county well located

LANDOWNER: Dave Roberts

description of formations encountered

from

to

Moorhead, Ms  
(mailing address)

clay	0'	18'
fine sand	18'	37'
med. to coarse sand	37'	55'
coarse sand	55'	85'
coarse sand & silt gravel	85'	114'

WELL LOCATION:

sec. 28 T. 19 N. R. 3 E  
4 miles S of Moorhead  
(distance) (direction) (nearest town)

WELL PURPOSE: irrigation  
(home, irrigation, municipal, industrial)

WELL COMPLETION DATA:

- (1) diameter (inches) 10"
- (2) total depth (feet) 114'
- (3) static water level (feet) 20' below top of ground.
- (4) casing steel, 74' (material) (depth)
- (5) screen 40' HD' steel 74' (length) (depth to top)
- (6) pump 10 (HP) 700 (yield gpm) electric (type power)
- (7) electric log NO (yes or no)

CODED

(organization running log)

(8) how well bottom plugged steel plate

DEPT. OF NATURAL RESOURCES  
BUREAU OF LAND & WATER RESOURCES


JUN 30 1980

RECEIVED

DRILLERS REMARKS:

If well telescopes please sketch and show depths.

GROUND LEVEL

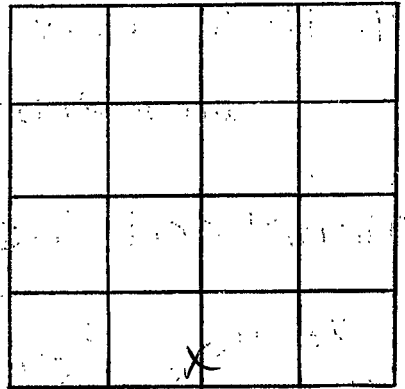

SECTION 28

Please indicate well location X.

ADDITIONAL INFORMATION

If more than one screen, show locations of each on sketch.