

MISSISSIPPI DEPARTMENT OF NATURAL RESOURCES
Bureau of Land and Water Resources
 Southport Mall
 P.O. Box 10631
 Jackson, Mississippi 39209
WATER WELL DRILLERS LOG

CODED

SUNFLOWER
Q-61
5-9-80

5-9 1980 Larry's Well & Pump Sunflower
 date well completed firm name county well located

LANDOWNER: Don Russell

description of formations encountered	from	to
---------------------------------------	------	----

Moorhead, Ms
 (mailing address)

<u>Clay</u>	<u>0'</u>	<u>20'</u>
<u>fine sand</u>	<u>20'</u>	<u>35'</u>
<u>med trace of coars sand</u>	<u>35'</u>	<u>47'</u>
<u>Coarse sand</u>	<u>47'</u>	<u>60'</u>
<u>Coarse sand & gravel</u>	<u>60'</u>	<u>116'</u>

WELL LOCATION:
 sec 26 T 18 N R 3 E
4 miles SE of Moorhead
 (distance) (direction) (nearest town)

WELL PURPOSE: Irrigation
 (home, irrigation, municipal, industrial)

WELL COMPLETION DATA:

- (1) diameter (inches) 10"
- (2) total depth (feet) 116'
- (3) static water level (feet) 23' below above top of ground.
- (4) casing steel, 76'
 (material) (depth)
 (size) if telescope see back.
- (5) screen 40', 76'
 (length) (depth to top)
10", steel
 (size) (material)
- (6) pump 10, 700
 (HP) (yield gpm)
electric
 (type power)
- (7) electric log No
 (yes or no)

(organization running log)

(8) how well bottom plugged steel plate

DRILLERS REMARKS:

CODED


DEPT. OF NATURAL RESOURCES
 BUREAU OF LAND & WATER RESOURCES

JUN 30 1980

RECEIVED

If well telescopes please sketch and show depths.

GROUND LEVEL

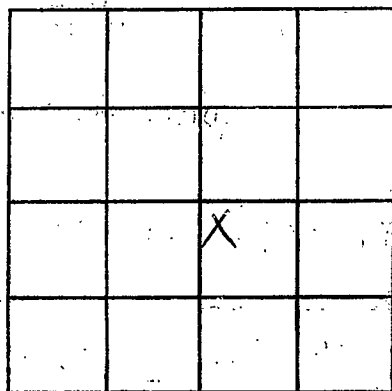

SECTION 26

Please indicate well location X.

ADDITIONAL INFORMATION

If more than one screen,
show locations of each on sketch.