

SUNFLOWER



MISSISSIPPI  
BOARD OF WATER COMMISSIONERS  
416 North State Street  
Jackson, Mississippi 39201

WATER WELL DRILLERS LOG

~~Polk~~  
R 66  
2/1/81

2-1-81 - 81 19 Sidney Cook Drilling Co.  
date well completed firm name county well located

LANDOWNER: Egans Hobbs  
Marehead Miss  
(mailing address)

description of formations encountered

from	to
<u>Top</u>	<u>30'</u>
<u>30'</u>	<u>50'</u>
<u>50'</u>	<u>110'</u>

WELL LOCATION:  
sec. 22 T. 18 N. R. 2 E. W. 8  
2 miles South of Marehead  
(distance) (direction) (nearest town)

WELL PURPOSE:  
(home, irrigation, municipal, industrial)

WELL COMPLETION DATA:

(1) diameter (inches) 8"

(2) total depth (feet) 110'

(3) static water level (feet) 33 below above top of ground.

(4) casing PVC 70'  
(material) (depth)  
80" if telescope see back.  
(size)

(5) screen 40' 70'  
(length) (depth to top)  
8" PVC  
(size) (material)

(6) pump 10 600  
(HP) (yield gpm)  
Blas  
(type power)

(7) electric log (yes or no)

(organization running log)

(8) how well bottom plugged Cap

CODED

DEPT. OF NATURAL RESOURCES  
BUREAU OF LAND & WATER RESOURCES


MAR - 4 1981

RECEIVED

DRILLERS REMARKS:

If well telescopes please sketch and show depths.

GROUND LEVEL

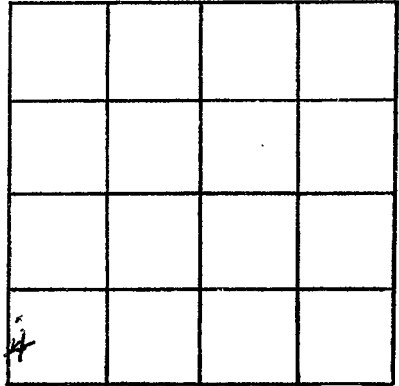

SECTION 22

Please indicate well location X.

ADDITIONAL INFORMATION

If more than one screen,  
show locations of each on sketch.