

MISSISSIPPI
BOARD OF WATER COMMISSIONERS
416 North State Street
Jackson, Mississippi 39201

~~Sunflower~~
SUNFLOWER
R 68
2/1/81

WATER WELL DRILLERS LOG

2-1-81 81 19 Sunflower Leech Pully Co.
date well completed firm name county well located

LANDOWNER:	description of formations encountered	from	to
<u>Egan Robbs</u>			
<u>Morehead Miss</u> (mailing address)	<u>Clay -</u>	<u>top</u>	<u>40'</u>
	<u>Font Sand</u>	<u>40'</u>	<u>70'</u>
	<u>Gravel & Sand</u>	<u>70'</u>	<u>110'</u>
WELL LOCATION:			
sec. <u>26</u> T. <u>18</u> N R. <u>3</u> W			
<u>2</u> miles <u>South</u> of <u>Morehead</u>			
(distance) (direction) (nearest town)			
WELL PURPOSE: (home, irrigation, municipal, industrial)			
WELL COMPLETION DATA:			
(1) diameter (inches) <u>8"</u>			
(2) total depth (feet) <u>110</u>			
(3) static water level (feet) <u>33'</u> below top of ground			
(4) casing <u>PVC</u> <u>70'</u> (material) (depth)			
<u>4"</u> if telescope see back. (size)			
(5) screen <u>40'</u> <u>70'</u> (length) (depth to top)			
<u>4"</u> <u>PVC</u> (size) (material)			
(6) pump <u>10</u> <u>600</u> (HP) (yield gpm)			
(type power)			
(7) electric log (yes or no)			
(organization running log)			
(8) how well bottom plugged <u>cap</u>			
DRILLERS REMARKS:			


CODED

DEPT. OF NATURAL RESOURCES
BUREAU OF LAND & WATER RESOURCES

MAR - 4 1981
RECEIVED

If well telescopes please sketch and show depths.

GROUND LEVEL

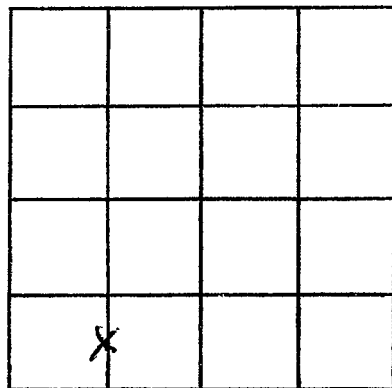

SECTION 26

Please indicate well location X.

ADDITIONAL INFORMATION

If more than one screen,
show locations of each on sketch.