

MISSISSIPPI DEPARTMENT OF NATURAL RESOURCES

Bureau of Land and Water Resources

Southport Mall

P.O. Box 10631

Jackson, Mississippi 39209


WATER WELL DRILLERS LOG

CODED

Sunflower
R 70
8/15/80

08/15 1980 data well completed Larry's Well & Pump firm name Sunflower county well located

LANDOWNER: <u>Wheeler Timbs</u>	description of formations encountered	from	to
<u>Moorhead, MS</u> (mailing address)	<u>flay</u>	<u>0</u>	<u>25</u>
	<u>fine sand</u>	<u>25</u>	<u>40</u>
	<u>coarse sand</u>	<u>40</u>	<u>60</u>
	<u>coarse sand & gravel</u>	<u>60</u>	<u>103</u>
WELL LOCATION: sec. <u>14</u> T. <u>18</u> N R. <u>3</u> E 3 1/2 miles <u>SE</u> of <u>MOORHEAD</u> (distance) (direction) (nearest town)			
WELL PURPOSE: <u>Sub Pump</u> (home, irrigation, municipal, industrial)			
WELL COMPLETION DATA: (1) diameter (inches) <u>16"</u> (2) total depth (feet) <u>103'</u> (3) static water level (feet) <u>25</u> below above top of ground. (4) casing <u>Steel</u> , <u>63'</u> (material) (depth) If telescope see back. (size) (5) screen <u>40'</u> , <u>63'</u> (length) (depth to top) <u>16"</u> , <u>steel</u> (size) (material) (6) pump <u>60</u> <u>Pro</u> (HP) (yield gpm) <u>Electric</u> (type power) (7) electric log <u>No</u> (yes or no) (organization running log) (8) how well bottom plugged <u>steel plate</u>			
DRILLERS REMARKS:			

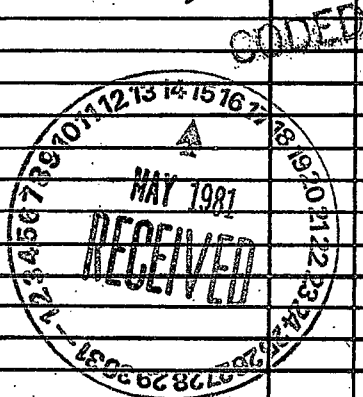

If well telescopes please sketch and show depths.

GROUND LEVEL

		X	

SECTION 14

Please indicate well location X.

ADDITIONAL INFORMATION

If more than one screen, show locations of each on sketch.