

MISSISSIPPI DEPARTMENT OF NATURAL RESOURCES

Bureau of Land and Water Resources

Southport Mall

P.O. Box 10631

Jackson, Mississippi 39209

WATER WELL DRILLERS LOG

CODED

Sunflower
R 73
10/8/80


10/80 date well completed

1980

Larry's Well & Pump firm name

Sunflower county well located

LANDOWNER:	description of formations encountered	from	to
Harris Russell			
Morehead Mo. (mailing address)	Clay FINE SAND BORGE SAND & GRAVEL	0 20 60	20 60 110
WELL LOCATION: sec. <u>22</u> T. <u>18</u> N. R. <u>3</u> E. W. <u>5</u> (distance) miles (direction) of <u>Morehead</u> (nearest town)			
WELL PURPOSE: <u>FISH Pond</u> (home, irrigation, municipal, industrial)			
WELL COMPLETION DATA:			
(1) diameter (inches)	<u>16"</u>		
(2) total depth (feet)	<u>110'</u>		
(3) static water level (feet)	<u>25'</u> below top of ground.		
(4) casing (material)	<u>Steel</u> , <u>70'</u> (depth)		
(size)	If telescope see back.		
(5) screen (length)	<u>40'</u> , <u>70'</u> (depth to top)		
(size)	<u>16"</u> , <u>Steel</u> (material)		
(6) pump (HP)	(yield gpm)		
(type power)			
(7) electric log (yes or no)	<u>No</u>		
(organization running log)			
(8) how well bottom plugged	<u>Steel Plate</u>		
DRILLERS REMARKS:			

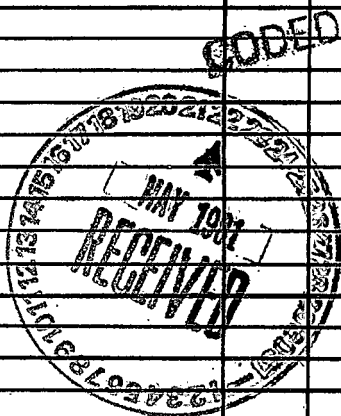

If well telescopes please sketch and show depths.

GROUND LEVEL

	X		

SECTION 22

Please indicate well location X.

ADDITIONAL INFORMATION

If more than one screen,
show locations of each on sketch.