

MISSISSIPPI DEPARTMENT OF NATURAL RESOURCES

Bureau of Land and Water Resources

Southport Mall

P.O. Box 10631

Jackson, Mississippi 39209

WATER WELL DRILLERS LOG

CODED

246-8202  
12:15  
12:30

SUNFLOWER  
R74  
11/14/80

11/14 1980  
date well completed

Larry's Well Pump  
firm name

Se. Florence  
county well located

LANDOWNER: <u>W. Timbo</u>	description of formations encountered	from	to
<u>Moorehead, MS.</u> (mailing address)	<u>slay</u>	<u>0</u>	<u>22</u>
	<u>fine sand</u>	<u>22</u>	<u>40</u>
	<u>med sand</u>	<u>40</u>	<u>55</u>
	<u>rough sand &amp; gravel</u>	<u>55</u>	<u>125</u>
	<u>slay</u>	<u>125</u>	<u>230</u>
	<u>sand &amp; clay</u>	<u>230</u>	<u>400</u>
	<u>sand</u>	<u>400</u>	<u>500</u>

WELL LOCATION:


35 13 T 18 N R 3 W  
NW 01 82 8W SE of Moorehead  
5 miles (distance) (direction) (nearest town)

WELL PURPOSE: household  
(home, irrigation, municipal, industrial)

WELL COMPLETION DATA: 200-4"


- (1) diameter (inches) 4" x 2"
- (2) total depth (feet) 500'
- (3) static water level (feet) 28 below above top of ground.
- (4) casing plastic, 460,  
(material) (depth)  
(size) if telescope see back.
- (5) screen 40, 460  
(length) (depth to top)  
2", plastic  
(size) (material)
- (6) pump 5, 80  
(HP) (yield gpm)  
(type power)
- (7) electric log NO  
(yes or no)  
(organization running log)
- (8) how well bottom plugged

DRILLERS REMARKS:

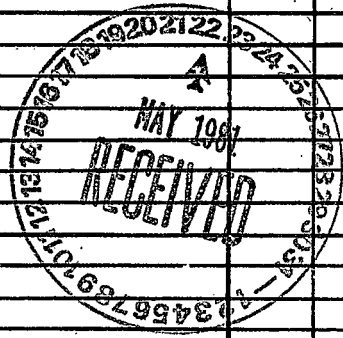

If well telescopes please sketch and show depths.

GROUND LEVEL

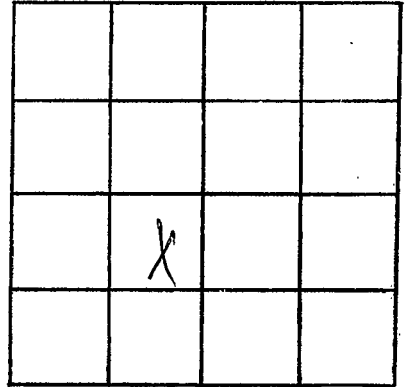

SECTION 13

Please indicate well location X.

ADDITIONAL INFORMATION

If more than one screen,  
show locations of each on sketch.