

Bureau of Land and Water Resources

Southport Mall

P.O. Box 10631

Jackson, Mississippi 39209

WATER WELL DRILLERS LOG

133

CODED

Sunflower  
R75  
3-9-81

3/9 1981  
date well completed

Dyer  
firm name

Sun.  
county well located

LANDOWNER:  
JACK ALLEN  
Indianola, MS.  
(mailing address)

Description of formations encountered	from	to
Clay	0	38
Gravel sand	38	45
Sand	45	68
Sand & gravel	68	113


WELL LOCATION:  
sec. 30 T. 18 N. R. 3 E. W. 4  
4 miles SW of Moorhead  
(distance) (direction) (nearest town)

WELL PURPOSE:  
(home, irrigation, municipal, industrial)

CODED

WELL COMPLETION DATA:

- (1) diameter (inches) 16
- (2) total depth (feet) 113'
- (3) static water level (feet) 20' below top of ground
- (4) casing (material) Steel (depth) 113'
- (5) screen (size) 16" (length) 40' (depth to top) 73'
- (6) pump (size) 16" (material) Steel (HP) 60 (yield gpm) 3000
- (7) electric log (yes or no) propane
- (8) how well bottom plugged plate

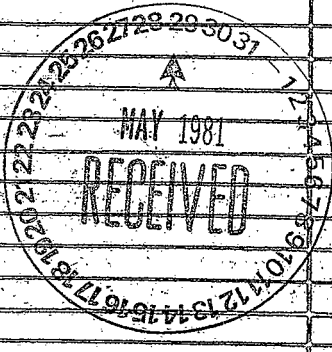

DRILLERS REMARKS:

X			

See 30