

Sunflower
R 76
3-7-81

MISSISSIPPI DEPARTMENT OF NATURAL
Bureau of Land and Water Resources
Southport Mall
P.O. Box 10631
Jackson, Mississippi 39209
WATER WELL DRILLERS LOG

133

CODED
Sun

3/7 1981 date well completed
Dyer firm name
Sun county well located

LANDOWNER:
JACK ALLEN
Indianola MS.
(mailing address)


description of formations encountered	from	to
Clay	0	26
fine sand	26	38
sand	38	68
sand & gravel	68	113

WELL LOCATION:
sec 30 T 150 R 3 E
S W
4 miles NB of Business
(distance) (direction) (nearest town)

WELL PURPOSES:
(home, irrigation, municipal, industrial)

- WELL COMPLETION DATA:
- (1) diameter (inches) 16
 - (2) casing depth (feet) 113
 - (3) static water level (feet) 21' below top of ground.
 - (4) casing Steel (material), 113' (depth), 16" (size) if telescope see back.
 - (5) screen 40' (length), 23' (depth to top), 16" (size), Steel (material)
 - (6) pump 60 (HP), 3000 (yield gpm), diesel (type power)
 - (7) electric log (yes or no)
 - (organization running log)
 - (8) how well bottom plugged plate

CODED

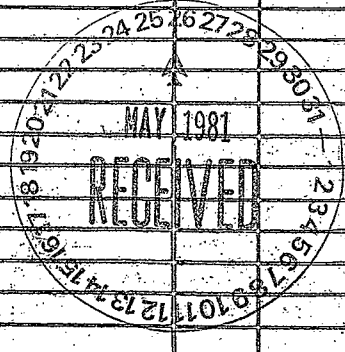

DRILLERS REMARKS:

x			

See 30