

Bureau of Land and Water Resources

Southport Mall

P.O. Box 10631

0004

Jackson, Mississippi 39209

WATER WELL DRILLERS LOG CODED

Sunflower
R 77
1- - 81

date well completed 1/81
driller name Dyer
county well located Sunflower

LANDOWNER:
BOBBY KINCAID

MOOREHEAD, MS
(mailing address)


WELL LOCATION:
sec. 11 T. 180 N. R. 3 E
1 miles S of Moorhead
(distance) (direction) (nearest town)

WELL PURPOSE:
(home, irrigation, municipal, industrial)


WELL COMPLETION DATA:
(1) diameter (inches) 16"
(2) total depth (feet) 113'
(3) static water level (feet) 22' below top of ground
(4) casing Steel 113'
(material) (depth)
16" (size) if telescope see back.
(5) screen 40' 73'
(length) (depth to top)
16" (size) Steel (material)
(6) pump 60 3000
(HP) (yield gpm)
deal (type power)
(7) electric log (yes or no)
(organization running log)
(8) how well bottom plugged plate

description of formations encountered	from	to
Clay	0	23
Thin sand	30	42
Sand	47	48
Sand + gravel	48	113

CODED

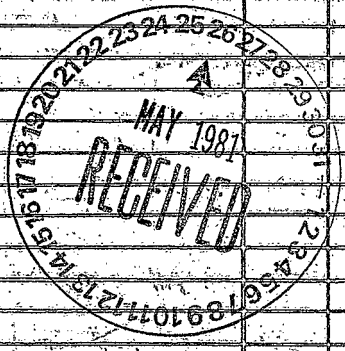

DRILLERS REMARKS:

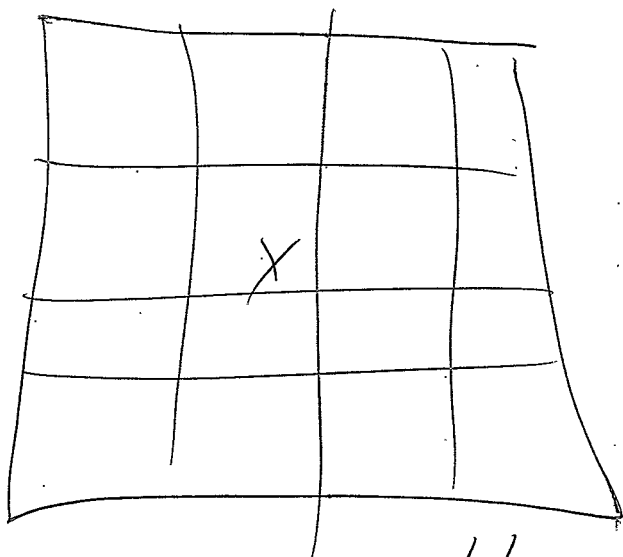

see 11