

MISSISSIPPI DEPARTMENT OF NATURAL RESOURCES

Bureau of Land and Water Resources

Southport Mall

P.O. Box 10631

Jackson, Mississippi 39209

WATER WELL DRILLERS LOG

CODED

Sunflower  
R78  
3-14-81

March 14 19 81  
date well completed

Larry's well & Pump  
firm name

Sunflower  
county well located

LANDOWNER: Harris Russell

description of formations encountered

from

to

Moorhead MS.  
(mailing address)

<u>slay</u>	<u>0</u>	<u>25</u>
<u>fine sand</u>	<u>25</u>	<u>40</u>
<u>red sand</u>	<u>40</u>	<u>60</u>
<u>med coarse sand</u>	<u>60</u>	<u>106</u>

WELL LOCATION:

sec. 11 T 18 N R 3 E  
3 miles E of Moorhead  
(distance) (direction) (nearest town)

WELL PURPOSE:

(home, irrigation, municipal, industrial)

WELL COMPLETION DATA:

- (1) diameter (inches) 12"
- (2) total depth (feet) 106'
- (3) static water level (feet) 26 below above top of ground.
- (4) casing Steel, 66' (material) (depth)  
(size) if telescope see back.
- (5) screen 40', 66' (length) (depth to top)  
12", Steel (size) (material)
- (6) pump 40 2000 (HP) (yield gpm)  
10 (type power)
- (7) electric log No (yes or no)  
(organization running log)

CODED

DEPT. OF NATURAL RESOURCES  
BUREAU OF LAND & WATER RESOURCES

(8) how well bottom plugged Steel Plate


JUN 3 - 1981

RECEIVE

DRILLERS REMARKS:

If well telescopes please sketch and show depths.

GROUND LEVEL

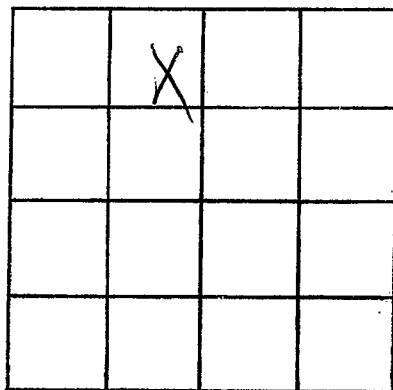

SECTION 11

Please indicate well location X.

ADDITIONAL INFORMATION

If more than one screen, show locations of each on sketch.