

MISSISSIPPI DEPARTMENT OF NATURAL RESOURCES

Bureau of Land and Water Resources

Southport Mall

P.O. Box 10631

Jackson, Mississippi 39209

WATER WELL DRILLERS LOG

CODED

Sunflower  
R79  
3-15-81

March 15 1981 Larry Well Pump Sunflower  
 date well completed firm name county well located

LANDOWNER: <u>Harris Russell</u>	description of formations encountered	from	to
<u>Moorhead, Ms.</u> (mailing address)	<u>slay</u>	0	25
	<u>fine sand</u>	25	40
	<u>med sand</u>	40	60
	<u>course sand &amp; gravel</u>	60	116'
WELL LOCATION: sec. <u>22</u> T <u>18</u> N R. <u>3</u> E <u>3</u> miles <u>S</u> of <u>Moorhead</u> (distance) (direction) (nearest town)			
WELL PURPOSE: <u>Full Pond</u> (home, irrigation, municipal, industrial)			
WELL COMPLETION DATA: (1) diameter (inches) <u>16"</u> (2) total depth (feet) <u>116'</u> (3) static water level (feet) <u>25'</u> <sup>below</sup> / <sub>above</sub> top of ground. (4) casing <u>steel</u> , <u>76'</u> (material) (depth) (size) if telescope see back. (5) screen <u>46'</u> , <u>76'</u> (length) (depth to top) <u>16"</u> , <u>Steel</u> (size) (material) (6) pump <u>100</u> <u>3000</u> (HP) (yield gpm) <u>Electric</u> (type power) (7) electric log <u>No</u> (yes or no) (organization running log) (8) how well bottom plugged <u>Steel</u> <u>Plate</u>			
DRILLERS REMARKS:			

CODED


DEPT. OF NATURAL RESOURCES  
 BUREAU OF LAND & WATER RESOURCES

JUN 3 1981

RECEIVED

If well telescopes please sketch and show depths.

GROUND LEVEL

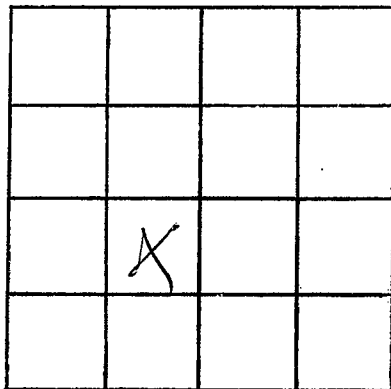

SECTION 22

Please indicate well location X.

ADDITIONAL INFORMATION

If more than one screen,  
show locations of each on sketch.