

MISSISSIPPI DEPARTMENT OF NATURAL RESOURCES

Bureau of Land and Water Resources

Southport Mall

P.O. Box 10631

Jackson, Mississippi 39209

WATER WELL DRILLERS LOG

CODED

Sunflower
R80
3-15-81

March 15 1981 date well completed
Lump's well & pump firm name
Sunflower county well located

| LANDOWNER: Floyd Anderson | description of formations encountered | from | to |
|---|--|---------------------|-----------------------|
| Inverness MS (mailing address) | clay fine sand medium sand course sand & silt | 0 25 40 60 | 25 40 60 115 |
| WELL LOCATION: sec. 32 T 11 N R 3 E 7 miles NW of Inverness (distance) (direction) (nearest town) | | | |
| WELL PURPOSE: (home, irrigation, municipal, industrial) | | | |
| WELL COMPLETION DATA: (1) diameter (inches) 16" (2) total depth (feet) 115' (3) static water level (feet) 55 below top of ground. (4) casing Steel 75' (material) (depth) (size) if telescope see back. (5) screen 40' 75' (length) (depth to top) 16" Steel (size) (material) (6) pump (HP) (yield gpm) (type power) (7) electric log NO (yes or no) (organization running log) (8) how well bottom plugged Steel Plate | | | |

CODED

DEPT. OF NATURAL RESOURCES
BUREAU OF LAND & WATER RESOURCES


JUN 3 - 1981

RECEIVED

DRILLERS REMARKS:

If well telescopes please sketch and show depths.

GROUND LEVEL

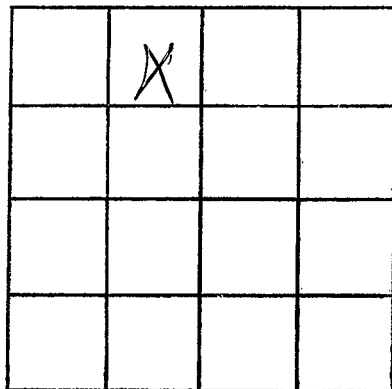

SECTION 32

Please indicate well location X.

ADDITIONAL INFORMATION

If more than one screen,
show locations of each on sketch.