

**MISSISSIPPI DEPARTMENT OF NATURAL RESOURCES**  
 Bureau of Land and Water Resources  
 Southport Mall  
 P.O. Box 10631  
 Jackson, Mississippi 39209  
**WATER WELL DRILLERS LOG**

**CODED**

Sanflower  
R 81  
5-21-81

5-21-81 date well completed     Dyer well - Jerry Lee firm name     Sanflower county well located

LANDOWNER: Paul Smilk  
Tram Fisheries  
Yazoo City, Ms 39194  
 (mailing address)

description of formations encountered	from	to
<u>Clay</u>	<u>0</u>	<u>26</u>
<u>fine sand</u>	<u>26</u>	<u>58</u>
<u>sand</u>	<u>38</u>	<u>68</u>
<u>sand &amp; gravel</u>	<u>68</u>	<u>113</u>

WELL LOCATION:  
 sec. 19 T. 18 S. R. 3 E.  
4.50 miles (distance) of Missoshead (direction) of Missoshead (nearest town)

WELL PURPOSE:  
 (home, irrigation, municipal, industrial)

WELL COMPLETION DATA:

(1) diameter (inches) 16

(2) total depth (feet) 113

(3) static water level (feet) 24 below/above top of ground

(4) casing 16 (material)          (depth)

16 (size) if telescope rod back.

(5) screen 40 (length)          (depth to top)

16 (size)          (material)

(6) pump 60 (HP)          (yield gpm)


Herold (type power)

(7) electric log no (yes or no)


         (organization running log)

(8) how well bottom plugged plate

**CODED**

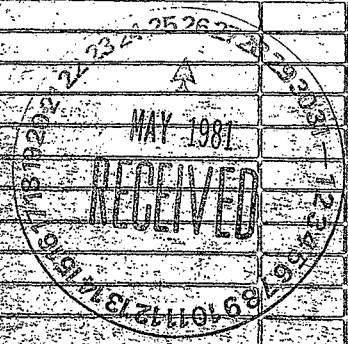

DRILLERS REMARKS:

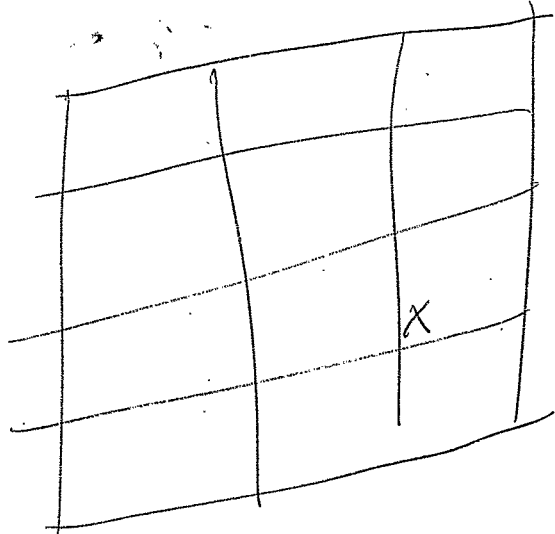

sec 19