

MISSISSIPPI DEPARTMENT OF NATURAL RESOURCES

Bureau of Land and Water Resources

Southport Mall

P.O. Box 10631

Jackson, Mississippi 39209

WATER WELL DRILLERS LOG CODED

Sunflower
295
3-13-81

March 13 1981
date well completed

Larry's Well & Pump
firm name

Sunflower
county well located

LANDOWNER:	description of formations encountered	from	to
Harris Russell			
moorhead MS (mailing address)	slay	0	25
	fine sand	25	40
	med sand	40	60
	loose sand & gravel	60	106
WELL LOCATION: sec. 15 T 18 N R 3 E S W			
1 miles S of Moorhead			
WELL PURPOSE: (home, irrigation, municipal, industrial)			
WELL COMPLETION DATA:			
(1) diameter (inches) 12"			
(2) total depth (feet) 106'			
(3) static water level (feet) 25' below top of ground.			
(4) casing (material) Steel (depth) 66'			
(size) If telescope see back.			
(5) screen (length) 40' (depth to top) 66'			
(size) 12" (material) Steel			
(6) pump (HP) 40 (yield gpm) 2 gpm			
(type power)			
(7) electric log (yes or no) No			
(organization running log)			
(8) how well bottom plugged Steel Plate			

CODED

DEPT. OF NATURAL RESOURCES
BUREAU OF LAND & WATER RESOURCES


JUN 8 - 1981

RECEIVED

DRILLERS REMARKS:

If well telescopes please sketch and show depths.

GROUND LEVEL

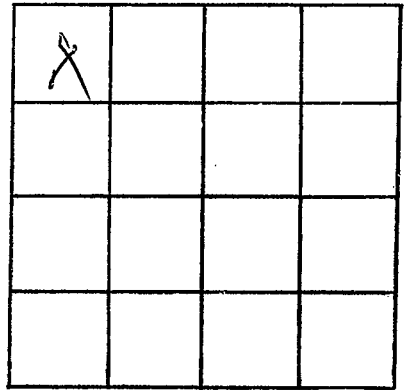

SECTION 15

Please indicate well location X.

ADDITIONAL INFORMATION

If more than one screen, show locations of each on sketch.