

MISSISSIPPI DEPARTMENT OF NATURAL RESOURCES

Bureau of Land and Water Resources

Southport Mall

P.O. Box 10631

Jackson, Mississippi 39209 CODEL

WATER WELL DRILLERS LOG

Sunflower  
R96  
3-14-81

March 14, 1981 date well completed  
Larry's Well & Pump firm name  
Sunflower county well located

LANDOWNER: Harris Russell	description of formations encountered	from	to
Moorhead, MS (mailing address)	clay fine sand med sand course sand	0 20 30 50	20' 30' 50' 100'
<b>WELL LOCATION:</b> sec. 11 T. 18 N. R. 3 E. W. 8 S. 3 miles E of Moorhead (distance) (direction) (nearest town)			
<b>WELL PURPOSE:</b> (home, irrigation, municipal, industrial)			
<b>WELL COMPLETION DATA:</b>			
(1) diameter (inches) 8"			
(2) total depth (feet) 100'			
(3) static water level (feet) 26' below above top of ground.			
(4) casing Plastic, 60' (material) (depth) (size) if telescope see back.			
(5) screen 40' 60' (length) (depth to top) 8" Plastic (size) (material)			
(6) pump 10 700 (HP) (yield gpm) Electric (type power)			
(7) electric log No (yes or no) (organization running log)			
(8) how well bottom plugged PVC cap			
DRILLERS REMARKS:			

CODED


DEPT. OF NATURAL RESOURCES  
BUREAU OF LAND & WATER RESOURCES

JUN 3 - 1981

RECEIVED

If well telescopes please sketch and show depths.

GROUND LEVEL

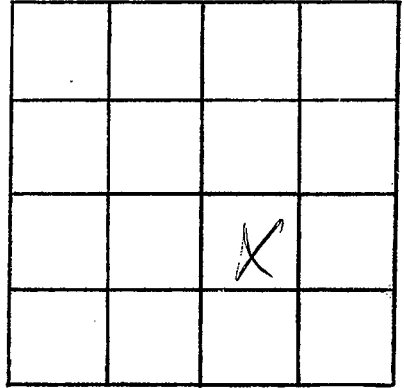

SECTION 11

Please indicate well location X.

ADDITIONAL INFORMATION

If more than one screen,  
show locations of each on sketch.