

SUNFLOWER
R 97

8-19-81

MISSISSIPPI DEPARTMENT OF NATURAL RESOURCES
Bureau of Land and Water Resources
Southport Mall
P.O. Box 10631
Jackson, Mississippi 39201
WATER WELL DRILLERS LOG

CODED

8-19

81 DYERWOOD TOWN

SUNFLOWER

date well completed

firm name

county well located

LANDOWNER:

A. R. Maxwell

description of formations encountered

from

to

MOORHEAD, MS
(mailing address)

WELL LOCATION:

sec. 20 T 18 N R 3 E
S W
3 miles SW of Moorhead
(distance) (direction) (nearest town)

CLAY CODED 0 18

fine sand 18 25

sand & gravel 25 113

WELL PURPOSE:

(home, irrigation, municipal, industrial)

WELL COMPLETION DATA:

- (1) diameter (inches) 16"
- (2) total depth (feet) 113'
- (3) static water level (feet) 21' below top of ground.
- (4) casing Steel, 73' (material) (depth)
76" (size) If telescope see back.
- (5) screen 40', 73' (length) (depth to top)
16" Steel (size) (material)
- (6) pump 60, 3000 (HP) (yield gpm)
Diesel (type power)
- (7) electric log no (yes or no)

(organization running log)

(8) how well bottom plugged

plate

DRILLERS REMARKS:


DEPT. OF NATURAL RESOURCES
BUREAU OF LAND & WATER RESOURCES

SEP 16 1981

RECEIVED

If well telescopes please sketch and show depths.

GROUND LEVEL

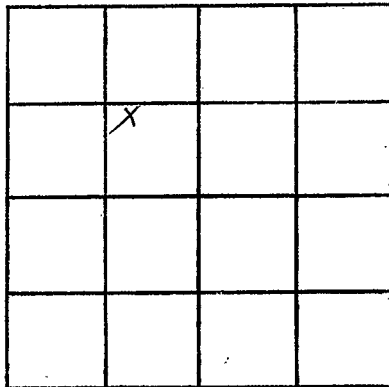

SECTION 20

Please indicate well location X.

ADDITIONAL INFORMATION

If more than one screen,
show locations of each on sketch.