

MISSISSIPPI
 BOARD OF WATER COMMISSIONERS
 416 North State Street
 Jackson, Mississippi 39201

WATER WELL DRILLERS LOG
 BUTANE GAS CO. OF GREENWOOD

Sunflower
R 101
10-11-69

10/11 1969 GREENWOOD, MISSISSIPPI Sunflower
 date well completed firm name county well located

LANDOWNER:

W. T. Timbs, JR.
Moorhead, Miss. S.
 (mailing address)

description of formations encountered

from to

<u>Clay</u>	<u>0</u>	<u>15</u>
<u>Sand + Clay</u>	<u>15</u>	<u>60</u>
<u>Sand + Gravel</u>	<u>60</u>	<u>94</u>

WELL LOCATION:

sec. 21 T 18 N R 3 E
5 W
2 miles 5 of Moorhead
 (distance) (direction) (nearest town)

WELL PURPOSE: Home
 (home, irrigation, municipal, industrial)

WELL COMPLETION DATA:

- (1) diameter (inches) 2
- (2) total depth (feet) 94
- (3) static water level (feet) 18 below above top of ground.
- (4) casing Steel 84
 (material) (depth)
2 If telescope see back.
 (size)
- (5) screen 10 84
 (length) (depth to top)
2 PVC
 (size) (material)
- (6) pump 3/4 10
 (HP) (yield gpm)
Elec
 (type power)
- (7) electric log No
 (yes or no)

(organization running log)

(8) how well bottom plugged
Lead Wool


DRILLERS REMARKS:

OCT 15 1969

MISS. BD. OF
 WATER COMM.

If well telescopes please sketch and show depths.

GROUND LEVEL

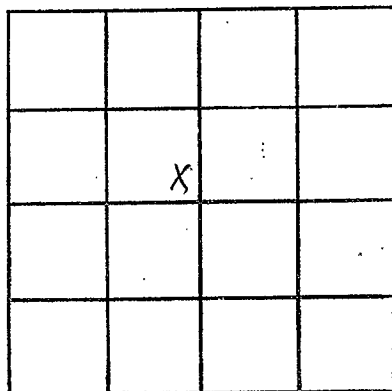

SECTION 21

Please indicate well location X.

ADDITIONAL INFORMATION

If more than one screen,
show locations of each on sketch.