

SUNFLOWER

R102

8-18-70

MISSISSIPPI  
 BOARD OF WATER COMMISSIONERS  
 416 North State Street  
 Jackson, Mississippi 39201

**CODED**

WATER WELL DRILLERS LOG

BUJANE GAS CO. OF GREENWOOD

Sunflower

8-18-70  
date well completed

firm name

county well located

LANDOWNER:

David E. Roberts

MOORHEAD, MISS.  
(mailing address)

WELL LOCATION:

sec. 20 T. 18 N. R. 3 W. 087

2 miles SW of Moorhead  
(distance) (direction) (nearest town)

WELL PURPOSE: Field  
(home, irrigation, municipal, industrial)

WELL COMPLETION DATA:

- (1) diameter (inches) 4 X 3
- (2) total depth (feet) 366
- (3) static water level (feet) 238 below top of ground.
- (4) casing Steel, 336 (material) (depth)  
4 X 3 (size) if telescope see back.
- (5) screen 30 336 (length) (depth to top)  
3" Stainless Steel (size) (material)
- (6) pump 2 38 (HP) (yield gpm)  
Elec. (type power)
- (7) electric log No (yes or no)

(organization running log)

(8) how well bottom plugged Back Pressure

description of formations encountered

from to

Clay	0	30
Sand	30	45
Sand & Gravel	45	120
Clay	120	135
Sand + Clay	135	274
Clay	274	279
Sand	279	370
Shale	370	385

**CODED**


SEP 1 1970

DRILLERS REMARKS:

MISS. Bd. OF WATER COMM.

If well telescopes please sketch and show depths.

GROUND LEVEL

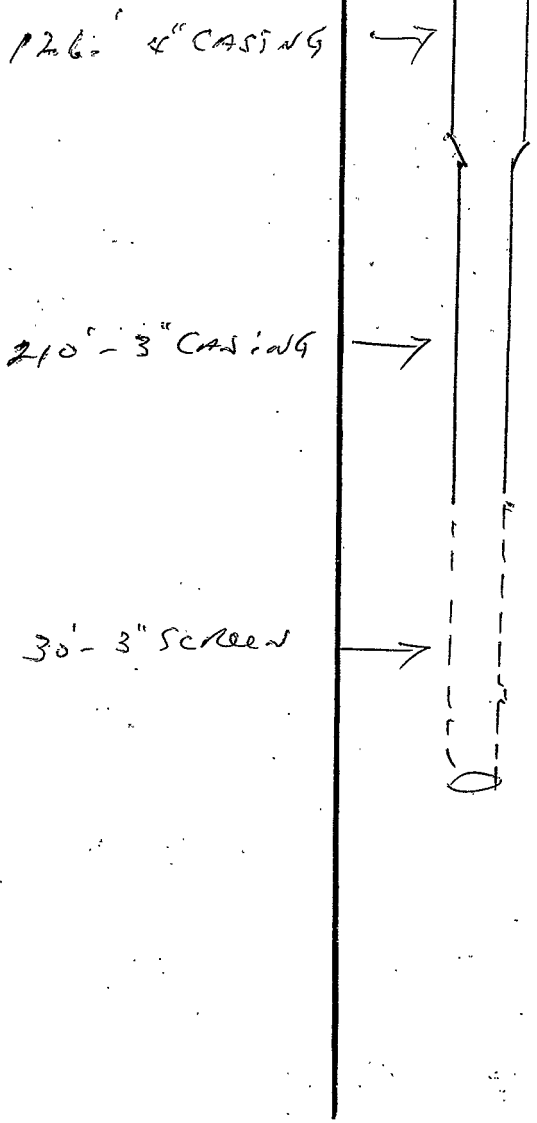

			X

SECTION 20

Please indicate well location X.

ADDITIONAL INFORMATION

Series of horizontal lines for additional information.

If more than one screen, show locations of each on sketch.