

MISSISSIPPI DEPARTMENT OF NATURAL RESOURCES

Bureau of Land and Water Resources

Southport Mall

P.O. Box 10631

Jackson, Mississippi 39209

WATER WELL DRILLERS LOG

18
CODED

Scuppernon
R103
5-1-81


date well completed May 01, 1981 firm name Lewis well & pump county well located Scuppernon

LANDOWNER: <u>Dave Roberts</u>	description of formations encountered	from	to
<u>Moorehead, Mo.</u> (mailing address)	<u>CLAY</u>	<u>0</u>	<u>40</u>
WELL LOCATION:	<u>FINE + MED SAND</u>	<u>40</u>	<u>65</u>
sec. <u>3</u> T <u>18</u> N R <u>3</u> W <u>2</u> miles <u>NE</u> of <u>Moorehead</u> (distance) (direction) (nearest town)	<u>COURSE SAND</u>	<u>65</u>	<u>100</u>
WELL PURPOSE: (home, irrigation, municipal, industrial)	CODED		
WELL COMPLETION DATA:			
(1) diameter (inches) <u>8"</u>			
(2) total depth (feet) <u>100'</u>			
(3) static water level (feet) <u>24</u> below top of ground. <u>above</u>			
(4) casing <u>Plastic</u> , <u>60'</u> (material) (depth)			
(size) if telescope see back.			
(5) screen <u>40'</u> , <u>60'</u> (length) (depth to top)			
(size) <u>8"</u> , <u>Plastic</u> (material)			
(6) pump <u>30</u> , <u>1400</u> (HP) (yield gpm)			
(type power)			
(7) electric log <u>No.</u> (yes or no)			
(organization running log)			
(8) how well bottom plugged <u>PVC</u> <u>cap</u>			
DRILLERS REMARKS:			

DEPT. OF NATURAL RESOURCES
BUREAU OF LAND & WATER RESOURCES
JUL 16 1981
RECEIVED

If well telescopes please sketch and show depths.

GROUND LEVEL

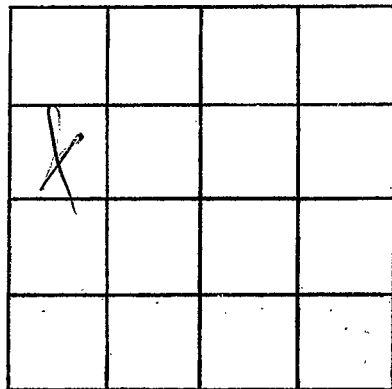

SECTION 2

Please indicate well location X.

ADDITIONAL INFORMATION

If more than one screen, show locations of each on sketch.