

MISSISSIPPI DEPARTMENT OF NATURAL RESOURCES

Bureau of Land and Water Resources

Southport Mall

P.O. Box 10631

CODED

Jackson, Mississippi 39209

WATER WELL DRILLERS LOG

Drummond  
R104  
5-1-81

date well completed May 01 19 81 Larry's well & pump firm name Drummond county well located

LANDOWNER: <u>Dave Roberts</u>	description of formations encountered	from	to
<u>Moorhead, MS</u> (mailing address)	<u>CLAY</u>	<u>0</u>	<u>40</u>
WELL LOCATION: sec. <u>3</u> T. <u>18</u> N R. <u>3</u> E <u>2</u> miles <u>NE</u> of <u>Moorhead</u> (distance) (direction) (nearest town)	<u>FINE + MED SAND</u>	<u>40</u>	<u>65</u>
WELL PURPOSE: (home, irrigation, municipal, industrial)	<u>COURSE SAND</u>	<u>65</u>	<u>100</u>
WELL COMPLETION DATA:	CODED		
(1) diameter (inches) <u>8"</u>			
(2) total depth (feet) <u>100'</u>			
(3) static water level (feet) <u>24</u> below above top of ground.			
(4) casing <u>Plastic</u> , <u>60'</u> (material) (depth) (size) if telescope see back.			
(5) screen <u>40'</u> , <u>60'</u> (length) (depth to top)			
(6) pump <u>8"</u> , <u>Plastic</u> (size) (material)			
(6) pump <u>15</u> , <u>900</u> (HP) (yield gpm)			
(type power) <u>Ele</u>			
(7) electric log <u>NO</u> (yes or no)			
(organization running log)			
(8) how well bottom plugged <u>PVC</u> <u>cap</u>			
DRILLERS REMARKS:			


DEPT OF NATURAL RESOURCES  
 BUREAU OF LAND & WATER RESOURCES

JUL 16 1981

RECEIVED

If well telescopes please  
sketch and show depths.

GROUND LEVEL

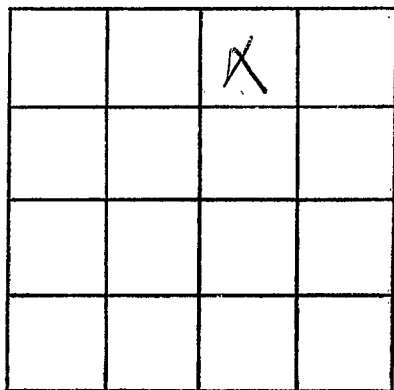

SECTION 3

Please indicate well location X.

ADDITIONAL INFORMATION

If more than one screen,  
show locations of each on sketch.