

MISSISSIPPI DEPARTMENT OF NATURAL RESOURCES
 Bureau of Land and Water Resources
 Southport Mall
 P.O. Box 10631
 Jackson, Mississippi 39209
WATER WELL DRILLERS LOG

CODED

Scuppernon
R105
6-11-8

June 11 1981 Larry's Well & Pump Scuppernon
 date well completed firm name county well located

LANDOWNER:	description of formations encountered	from	to
<u>Harris Russell</u>			
<u>Moorhead MS</u> (mailing address)	<u>clay</u> <u>fine sand</u> <u>shale to coarse</u>	<u>0</u> <u>28</u> <u>50</u>	<u>28</u> <u>50</u> <u>108</u>
WELL LOCATION: sec. <u>22</u> T. <u>18</u> N R. <u>3</u> E <u>3</u> miles <u>1</u> of <u>Moorhead</u> (distance) (direction) (nearest town)			
WELL PURPOSE: <u>farm land</u> (home, irrigation, municipal, industrial)			
WELL COMPLETION DATA:			
(1) diameter (inches) <u>16"</u>			
(2) total depth (feet) <u>108'</u>			
(3) static water level (feet) <u>26</u> below top of ground.			
(4) casing <u>Steel</u> , <u>68'</u> (material) (depth)			
(size) If telescope see back.			
(5) screen <u>40'</u> , <u>68'</u> (length) (depth to top)			
<u>16"</u> , <u>Steel</u> (size) (material)			
(6) pump <u>100</u> <u>3000</u> (HP) (yield gpm)			
(type power)			
(7) electric log <u>No</u> (yes or no)			
(organization running log)			
(8) how well bottom plugged <u>Steel</u> <u>Plate</u>			
DRILLERS REMARKS:			


CODED

DEPT. OF NATURAL RESOURCES
 BUREAU OF LAND & WATER RESOURCES

JUL 16 1981
RECEIVED

If well telescopes please sketch and show depths.

GROUND LEVEL

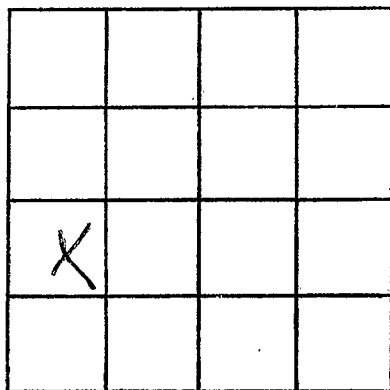

SECTION 22

Please indicate well location X.

ADDITIONAL INFORMATION

If more than one screen, show locations of each on sketch.