

MISSISSIPPI DEPARTMENT OF NATURAL RESOURCES
Bureau of Land and Water Resources
 Southport Mall
 P.O. Box 10631
 Jackson, Mississippi 39209
WATER WELL DRILLERS LOG CODED

Sunflower
R 106
9-18-81

9-18 1981 Dyer Well + Irrigation Sunflower
 date well completed firm name county well located

LANDOWNER: Bill Stowers

INVERNESS ms.
 (mailing address)

WELL LOCATION:
 sec. 24 T 18 N R. 3 E
5 miles OSE of Hardhead
 (distance) (direction) (nearest town)

WELL PURPOSE: Irrigation
 (home, irrigation, municipal, industrial)


- WELL COMPLETION DATA:
- (1) diameter (inches) 16"
- (2) total depth (feet) 110'
- (3) static water level (feet) 22' below above top of ground.
- (4) casing Steel, 70',
 (material) (depth)
16" If telescope see back.
 (size)
- (5) screen 40', 70'
 (length) (depth to top)
16", Steel
 (size) (material)
- (6) pump 60 3000
 (HP) (yield gpm)
electric
 (type power)
- (7) electric log No
 (yes or no)
None
 (organization running log)
- (8) how well bottom plugged Plate

description of formations encountered	from	to
Clay	0	15
fine sand	15	25
sand + gravel	25	110
CODED		
DEPT. OF NATURAL RESOURCES BUREAU OF LAND & WATER RESOURCES		
OCT - 1 1981		
RECEIVED		

DRILLERS REMARKS:

If well telescopes please sketch and show depths.

GROUND LEVEL

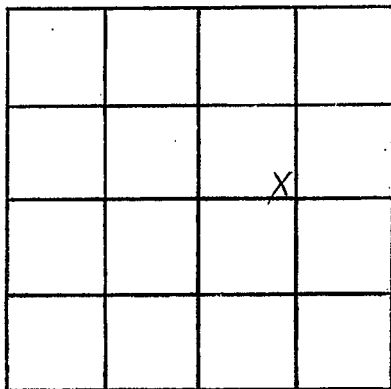

SECTION 24

Please indicate well location X.

ADDITIONAL INFORMATION

If more than one screen,
show locations of each on sketch.