

MISSISSIPPI DEPARTMENT OF NATURAL RESOURCES
 Bureau of Land and Water Resources
 Southport Mall
 P.O. Box 10631
 Jackson, Mississippi 39209
WATER WELL DRILLERS LOG

Sunflower
R 107
9/18/81

CODED

9-18 1981 Dyer Well + Irrigation Sunflower
 date well completed firm name county well located

LANDOWNER: Transfisheries
Paul Smith
MOORHEAD, MS.
 (mailing address)

| description of formations encountered | from | to |
|---------------------------------------|-----------|------------|
| <u>Clay</u> | <u>0</u> | <u>70</u> |
| <u>Sand</u> | <u>76</u> | <u>76</u> |
| <u>Sand + Gravel</u> | <u>76</u> | <u>113</u> |

WELL LOCATION:
 sec. 10 T. 18 N. R. 3 E. W. 1
1 miles E of Moorehead
 (distance) (direction) (nearest town)

WELL PURPOSE: Irrigation
 (home, (irrigation), municipal, industrial)

WELL COMPLETION DATA:

- (1) diameter (inches) 16"
- (2) total depth (feet) 113'
- (3) static water level (feet) 22' below top of ground.
- (4) casing Steel, 73'
 (material) (depth)
16" if telescope see back.
 (size)
- (5) screen 40', 73'
 (length) (depth to top)
16", Mild Steel
 (size) (material)
- (6) pump 60 2800-3000
 (HP) (yield gpm)
Diesel
 (type power)
- (7) electric log No
 (yes or no)
Nasc
 (organization running log)
- (8) how well bottom plugged Plastic

CODED

DEPT. OF NATURAL RESOURCES
 BUREAU OF LAND & WATER RESOURCES


OCT - 1 1981

RECEIVED

DRILLERS REMARKS:

If well telescopes please sketch and show depths.

GROUND LEVEL

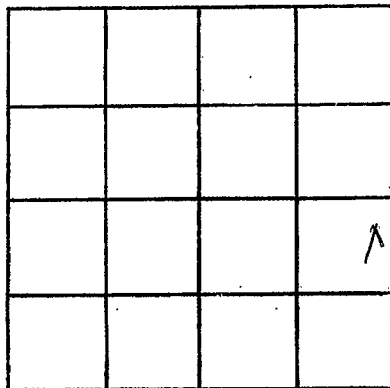

SECTION 10

Please indicate well location X.

ADDITIONAL INFORMATION

If more than one screen,
show locations of each on sketch.