

SUNFLOWER  
R 109  
2-1-81

MISSISSIPPI  
BOARD OF WATER COMMISSIONERS  
416 North State Street  
Jackson, Mississippi 39201

CODED

WATER WELL DRILLERS LOG

*Sunflower*  
*Bohannon*

2-1-81 date well completed 1981 *Sunflower* firm name *Bohannon* county well located

LANDOWNER:  
*Egan Robles Hodges*  
*Woodhead mine*  
(mailing address)

description of formations encountered	from	to
<i>Clay</i>	<i>Tap</i>	<i>30'</i>
<i>Loose sand</i>	<i>30'</i>	<i>50'</i>
<i>Sand &amp; gravel</i>	<i>50'</i>	<i>110'</i>

WELL LOCATION:  
sec. *22* T *18* N R *2* E  
*2* miles *South* of *Woodhead*  
(distance) (direction) (nearest town)

WELL PURPOSE: *Domestic*  
(home, irrigation, municipal, industrial)

- WELL COMPLETION DATA:
- (1) diameter (inches) *8"*
  - (2) total depth (feet) *110'*
  - (3) static water level (feet) *32'* below top of ground
  - (4) casing *PVC* *70'*  
(material) (depth)  
*8"* if telescope see back.  
(size)
  - (5) screen *40'* *70'*  
(length) (depth to top)  
*8"* *PVC*  
(size) (material)
  - (6) pump *10* *600*  
(HP) (yield gpm)  
*Levi*  
(type power)
  - (7) electric log \_\_\_\_\_  
(yes or no)
  - (organization running log)
  - (8) how well bottom plugged *Caps*

CODED

DEPT. OF NATURAL RESOURCES  
BUREAU OF LAND & WATER RESOURCES


OCT - 6 1981

RECEIVED

DRILLERS REMARKS:

If well telescopes please sketch and show depths.

GROUND LEVEL

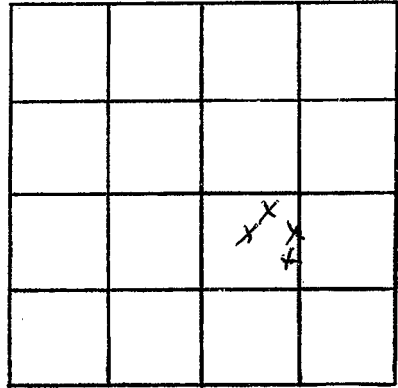

SECTION 22

Please indicate well location X.

ADDITIONAL INFORMATION

If more than one screen, show locations of each on sketch.