

SUNFLOWER
R110
R
2-1-81

MISSISSIPPI
BOARD OF WATER COMMISSIONERS
416 North State Street
Jackson, Mississippi 39201

CODED

WATER WELL DRILLERS LOG

Sunflower
Bolton
county well located

2-1-1981 date well completed
81 Sedley Creek Drilling Co. firm name

LANDOWNER:	description of formations encountered	from	to
Egar Bolton Hodges Merched miss (mailing address)			
WELL LOCATION: sec. 22 T 18 N R 3 E W 2 miles south of Merched (distance) (direction) (nearest town)			
WELL PURPOSE: irrigation (home, irrigation, municipal, industrial)			
WELL COMPLETION DATA:			
(1) diameter (inches) 8"			
(2) total depth (feet) 110'			
(3) static water level (feet) 5' below top of ground			
(4) casing PVC 70' (material) (depth) 8" (size) if telescope see back.			
(5) screen 40' 70' (length) (depth to top) 8" PVC (size) (material)			
(6) pump 10 HP 600 (type power) (yield gpm) Elec			
(7) electric log (yes or no)			
(organization running log)			
(8) how well bottom plugged Clog			

CODED.

DEPT. OF NATURAL RESOURCES
BUREAU OF LAND & WATER RESOURCES


OCT 6 1981

RECEIVED

DRILLERS REMARKS:

If well telescopes please sketch and show depths.

GROUND LEVEL

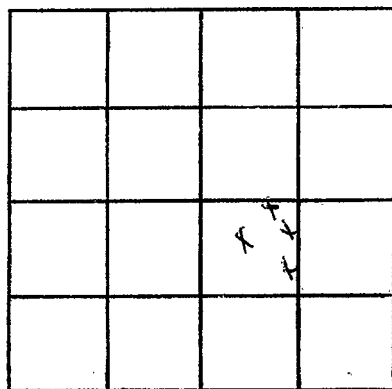

SECTION 22

Please indicate well location X.

ADDITIONAL INFORMATION

If more than one screen,
show locations of each on sketch.