

SUNFLOWER

MISSISSIPPI
BOARD OF WATER COMMISSIONERS
416 North State Street
Jackson, Mississippi 39201

CODED

R III

2-1-81

WATER WELL DRILLERS LOG

Sunflower

2-1
date well completed

1981

Litho-tek-1 Valley Co.
firm name

county well located

LANDOWNER:

Egan + Lodge
Hester

description of formations encountered

from to

moorhead min
(mailing address)

clay
sand & gravel
sand & gravel

Top 30'
38 50'
50' 110'

WELL LOCATION:

sec 22 T18 N R 3 E W
2 miles south of Moorhead
(distance) (direction) (nearest town)

WELL PURPOSE: Irrigation
(home, irrigation, municipal, industrial)

WELL COMPLETION DATA:

- (1) diameter (inches) 8"
- (2) total depth (feet) 170'
- (3) static water level (feet) 33' below top of ground
- (4) casing PVC 70'
(material) (depth)
- (size) if telescope see back.
- (5) screen 40 70'
(length) (depth to top)
- 8" PVC
(size) (material)
- (6) pump 10 600
(HP) (yield gpm)
- Electric
(type power)
- (7) electric log (yes or no)
- (organization running log)

CODED

(8) how well bottom plugged
plug

DRILLERS REMARKS:


DEPT. OF NATURAL RESOURCES
BUREAU OF LAND & WATER RESOURCES

OCT - 6 1981

RECEIVED

If well telescopes please sketch and show depths.

GROUND LEVEL

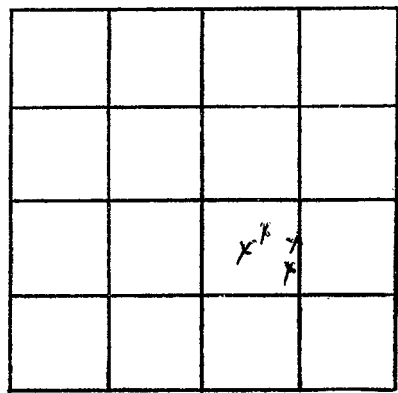

SECTION _____

Please indicate well location X.

ADDITIONAL INFORMATION

If more than one screen, show locations of each on sketch.