

SUNFLOWER
 R 112
 2-1-81

MISSISSIPPI
 BOARD OF WATER COMMISSIONERS
 416 North State Street
 Jackson, Mississippi 39201

CODED

WATER WELL DRILLERS LOG

Sunflower
County

2-7-81 date well completed 1981 *Sunflower* firm name county well located

LANDOWNER: *Hodges*
Egan
moorehead (mailing address)

description of formations encountered	from	to
<i>Clay</i>	<i>142</i>	<i>30'</i>
<i>Sand</i>	<i>50'</i>	<i>50'</i>
<i>Sand & gravel</i>	<i>50'</i>	<i>110'</i>

WELL LOCATION:
 sec. *12* T. *18* N. R. *3* E
2 miles *South* of *Marshall*
 (distance) (direction) (nearest town)

WELL PURPOSE:
 (home, irrigation, municipal, industrial)

- WELL COMPLETION DATA:
- diameter (inches) *8"*
 - total depth (feet) *110'*
 - static water level (feet) *33'* below top of ground.
 - casing *PVC* *70'*
 (material) (depth)
8" if telescope see back.
 (size)
 - screen *40'* *70'*
 (length) (depth to top)
8" *PVC*
 (size) (material)
 - pump *10* *600*
 (HP) (yield gpm)
Electric
 (type power)
 - electric log _____
 (yes or no)
 - (organization running log)
 - how well bottom plugged _____

CODED

DEPT. OF NATURAL RESOURCES
 BUREAU OF LAND & WATER RESOURCES


OCT - 6 1981

RECEIVED

DRILLERS REMARKS:

If well telescopes please sketch and show depths.

GROUND LEVEL

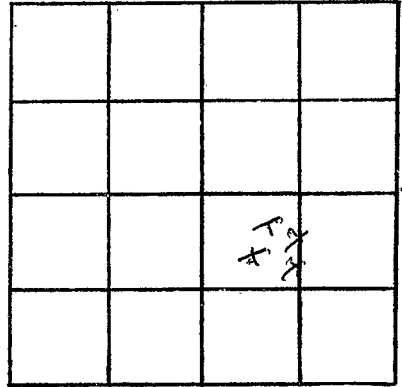

SECTION _____

Please indicate well location X.

ADDITIONAL INFORMATION

If more than one screen,
show locations of each on sketch.